

MISSISSIPPI DEPARTMENT OF NATURAL RESOURCES

Bureau of Land and Water Resources

Southport Mall

P.O. Box 10631

Jackson, Mississippi 39209 **CODED**

WATER WELL DRILLERS LOG

Humphreys  
B720  
3-18-81

March 18 1981 date well completed      Larry's Pump firm name      Humphreys county well located

LANDOWNER: <u>Halbrook</u>	description of formations encountered	from to	
		feet	feet
<u>Belzoni, MS.</u> (mailing address)	<u>CLAY</u>	<u>0</u>	<u>75</u>
	<u>FINE &amp; MED SAND</u>	<u>40</u>	<u>75</u>
	<u>COURSE SAND &amp; GRAVEL</u>	<u>75</u>	<u>116</u>


WELL LOCATION:  
sec. 25 T-16 N R-4 E  
S W  
6 miles W of Belzoni  
(distance) (direction) (nearest town)

WELL PURPOSE: Fish Pond  
(home, irrigation, municipal, industrial)

WELL COMPLETION DATA:

**CODED**

- (1) diameter (inches) 16"
- (2) total depth (feet) 116'
- (3) static water level (feet) 23' below top of ground.
- (4) casing Steel, 76'  
(material) (depth)
- \_\_\_\_\_ If telescope see back.  
(size)
- (5) screen 40', 76'  
(length) (depth to top)
- 16", Steel  
(size) (material)
- (6) pump 60, 3000  
(HP) (yield gpm)
- Electric  
(type power)
- (7) electric log No  
(yes or no)
- \_\_\_\_\_ (organization running log)
- (8) how well bottom plugged Steel Plate

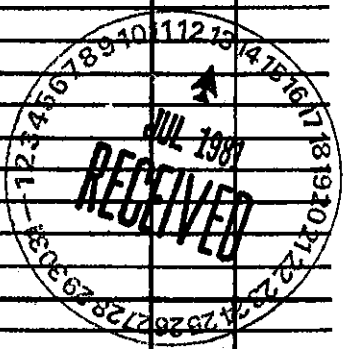

DRILLERS REMARKS: