

Humphreys?
B 167

MISSISSIPPI DEPARTMENT OF NATURAL RESOURCES
 Bureau of Land and Water Resources
 Southport Mall
 P.O. Box 10631
 Jackson, Mississippi 39209

CODED

WATER WELL DRILLERS LOG HUMPHREYS

June 6, 1986 date well completed Dyer Well, Inc. firm name Stamps county well located

LANDOWNER: Jim Higginbotham
702 Bowles St.
Belzoni, Miss.
 (mailing address)


WELL LOCATION:
 sec. 3 T. 16(N)? R. 5 E
7 miles West of Isola
 (distance) (direction) (nearest town)

WELL PURPOSE: Fish Culture
 (home, irrigation, municipal, industrial)

- WELL COMPLETION DATA:
- (1) diameter (inches) 16"
 - (2) total depth (feet) 110'
 - (3) static water level (feet) 23 below above top of ground.
 - (4) casing Steel, 69' (material), (depth)
16" (size) if telescope see back.
 - (5) screen 40', 70' (length), (depth to top)
16", Mild Steel (size), (material)
 - (6) pump 60, 2800 (HP), (yield gpm)
DIESEL (type power)
 - (7) electric log No (yes or no)
 (organization running log)
 - (8) how well bottom plugged Plate

description of formations encountered	from	to
Clay	0	15
Medium Fine Sand	15	35
Fine Sand	35	50
Medium Sand	50	70
Sand + Gravel	70	90
Fine Sand	90	95
Sand Gravel	95	110

CODED

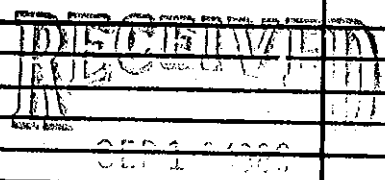

Department of Natural Resources
 Bureau of Land & Water Resources

DRILLERS REMARKS: