

MISSISSIPPI DEPARTMENT OF NATURAL RESOURCES

Bureau of Land and Water Resources

Southport Mall

P.O. Box 10631

Jackson, Mississippi 39209

WATER WELL DRILLERS LOG


Humphreys
B 173
7-15-86

CODED.

date well completed July 15 1986 firm name Lump Well & Pump county well located Humphreys

LANDOWNER: <u>Becker Farms</u>	description of formations encountered	from	to
<u>Becker Farms</u>			
<u>Becker Farms</u> (mailing address)	<u>clay</u>	<u>0</u>	<u>30</u>
	<u>fine sand</u>	<u>30</u>	<u>85</u>
	<u>coarse sand & gravel</u>	<u>85</u>	<u>130</u>
WELL LOCATION: sec. <u>12</u> T. <u>16</u> N R. <u>4</u> E S <u>1</u> W <u>1</u> E miles <u>1.5</u> of <u>Isola</u> (distance) (direction) (nearest town)			
WELL PURPOSE: (home, irrigation, municipal, industrial)			
WELL COMPLETION DATA: (1) diameter (inches) <u>12"</u> (2) total depth (feet) <u>130'</u> (3) static water level (feet) <u>27'</u> ^(below) above top of ground. (4) casing <u>Steel</u> , <u>90'</u> (material) (depth) <u> </u> If telescope see back. (size) (5) screen <u>40'</u> , <u>90'</u> (length) (depth to top) <u>12"</u> , <u>Steel</u> (size) (material) (6) pump <u>40</u> , <u>2000</u> (HP) (yield gpm) <u>0</u> (type power) (7) electric log <u>No</u> (yes or no) <u> </u> (organization running log) (8) how well bottom plugged <u>Steel Plate</u>			
DRILLERS REMARKS:			

CODED.

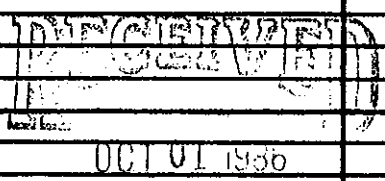

Department of Natural Resources
 Bureau of Land & Water Resources