County: Humphreys Permit #:
Permit #:
P.O. Box 10631 Jackson, MS 39289-0631 L. S. Elevation: [601)354-6938 (fax) State Law requires that this report be prepared by the driller in detail and filed with the Department within 30 days of completion of drilling of the well. Well Owner Information Well Location
Driller: Jackson, MS 39289-0631 Date drilling completed: 6-30-05 State Law requires that this report be prepared by the driller in detail and filed with the Department within 30 days of completion of drilling of the well. Well Owner Information U. S. Elevation:
Date drilling completed: 6-30-05 (601)961-5210 (601)354-6938 (fax) State Law requires that this report be prepared by the driller in detail and filed with the Department within 30 days of completion of drilling of the well. Well Owner Information Well Location
State Law requires that this report be prepared by the driller in detail and filed with the Department within 30 days of completion of drilling of the well. Well Owner Information Well Location
30 days of completion of drilling of the well. Well Owner Information Well Location
30 days of completion of drilling of the well. Well Owner Information Well Location
W-12 - M-12 - M-
Owner Name Danny Cordell Latitude: " "Longitude: " "Longitude: " "
Mailing Address: 1230 Montgomery St. Method of Lat/Long (circle one): Conventional Survey,
USGS quad, Hand-held GPS, Survey-grade GPS
SE 14 NE 14 Sec 14 Twn 16N Rng 5W
Inverness, MS 38753
City State Zip Code Distance Direction Nearest Town 662-265-5130
Telephone No. ()
Well Data
WGI DAG
Purpose of Well (circle one) Home Industrial Public Supply Trigation Fish Culture Other:
Date well drilling started: $6-30-05$ Date well drilling completed: $6-30-05$
If flowing, method of flow regulation: Valve Other (describe)
Static Water Level: 34' feet above or felow (circle one) land surface Date measured: 7-1-05
Method of Measurement (circle one) steel tape electric tape air line other:
Hole depth: 128 Well depth: 128 Well grouted to a depth of 10 feet
Type of grout (circle one): Cement Bentonite Mix
Casing length: 88 feet Casing diameter: 10 inches Type of casing: PVC
Screen length: 40 feet Screen diameter: 10 inches Type of screen: DVC 160
Screen slot size:
Screen slot size:
Type of completion (circle all applicable): Gravel packed Underreamed Telescoped Open hole Natural Development

Name of organization running log(s):

I certify that the well was drilled, constructed, and completed in accordance with all applicable requirements of the Mississippi

Department of Environmental Quality and/or the Mississippi Department of Health regulations and state laws.

0695

Irrigation Equipment Inc.

Patrick M. Chism

Print Name of Water Well Contractor and License No.

RECEIVED

Signature of Water Well Contractor


JUL 2 1 2005

BY: OLWR

Ground Level

Description of Formations Encountered	From	To
Clay	0	[31]
Fine Sand/gravel	32	45
Fine Sand/gravel Fine Sand	46	55
Fine Sand/gravel Med. Sand/gravel	56	85
Med. Sand/gravel	86	128
	<u>L</u> .	
	<u> </u>	
	<u></u>	
	1	$oldsymbol{ol}}}}}}}}}}}}}}}}}}$
	T	
	1	\top
		1
<u></u>		

If more than one screen, show location of each on sketch

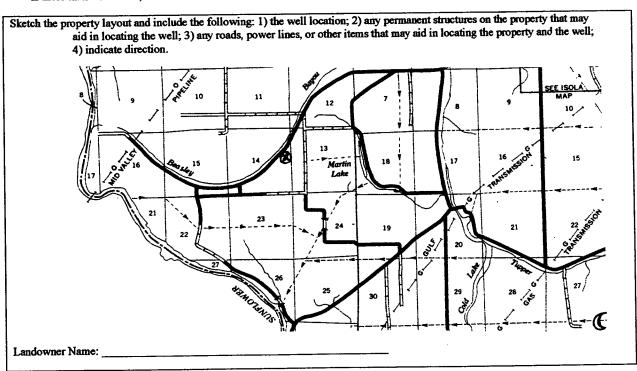

Signature of Water Well Contractor

STATE WELL REPORT

County: Humphreys Permit#: Irrigation Equipment Driller: 7-1-05

Part 2
Pump Installer's Completion Report
Mississippi Department of Environmental Quality
Office of Land and Water Resources
P.O. Box 10631
Jackson, MS 39289-0631
(601)961-5210

(601)354-6938 (fax)

For Office Use Only:		
Aquifer:		
Well#: B-230		
Elevation:		

This report should be prepared by the pump installer in detail and filed with the Department within 30 days of the installation of pump

Well Owner Information		Well Location		
Owner Name:	Danny Cordell	Latitude: Longitude:		
Mailing Address:	1230 Montgomery St.	tgomery St. Method of Lat/Long (circle one): Conventional Survey,		
		USGS quad, Hand-held GPS, Survey-grade GPS		
	Inverness MS 38753	SE, NE % Sec 14 Twn 16N Rng 5W		
	City State Zip Code			
Telephone No. (662-265-5130	Distance Direction Nearest Town SW of Isola		

Pump Type Circle one		Power Type Circle one			
Air Lift	Jet	Submersible	Diesel Engine	Gasoline Engine	Natural Gas
Bucket	Piston	Turbine	Electric Motor	Hand	Tractor PTO
Centrifugal	Rotary	Flowing Well	Windmill	Other (specify):	-
Other (specify):			Horse Power Rating	g of Motor: 10	
Date Pump Installed:	7-	1-05	Setting Depth:	70	feet
Rated Pump Capacity:	500	Gallons Per Minute	Number of Stages:	1	

Pump Test Data	Method of Measuring Water Level Circle one		
Date Well Tested:			
Static Water Level (A):Feet Below Land Surface	Air Line Electric Measuring Line Steel Tape		
Pumping Water Level (B):Feet Below Land Surface	Other (specify):		
Drawdown [(B) - (A)]:Feet Below Land Surface	For flowing well, measured shut in head:feet		
Test Pumping Rate:Gallons Per Minute	Well yieldedGPM with a drawdown of		
Duration of Pump Test (minimum 4 hours):hours	feet afterhours of pumping		

I HEREBY CERTIFY that the above statements are true to the best	t of my knowledge.	
Patrick M. Chism 0695	Patrid M Chim	
Print Name of Pump Installer and License No. (if applicable)	Signature of Pump Installer	

RECEIVED