,•]	State We	ell Report	For Office Use Only:
County: Humphreys	Pa	art 1	FOI OHRE OR Only.
		of Environmental Quality	Aquifer:
Permit #: $(\mathcal{O}\mathcal{V} + 404.74)$		nd Water Resources	Well #: B-23/
Irrigation Equipment	P.O. Box 10631		
Driller:		S 39289-0631	L. S. Elevation:
Date drilling completed: $6-30-05$	-	61-5210	
		-6938 (fax)	E-log #:
State Law requires that this report 30 days of completion of drilling of	be prepared by the o the well.	driller in detail and filed w	ith the Department within
Well Owner Information		Wel	Location
Danny Cordell			n
Owner Name		Lantude:	_" Longitude:'"
Mailing Address: 1230 Montgom	ery St.	Method of Lat/Long (circle or	e): Conventional Survey,
		USGS quad, Hand-held	GPS, Survey-grade GPS
Inverness, M	s 38753	<u>SW 1/4 SW 1/4 Sec 14</u>	Twn16N_Rng_5W
City State	Zip Code	Distance Direction	Nearest Town
•	•	Distance Direction <u>6</u> Miles SW	ofIsola
Telephone No. (662-265-5130			
	Well D		
Purpose of Well (circle one) Home Industr			Other:
Date well drilling started: $6-30-0$	5 Date w	vell drilling completed: $\frac{6-3}{2}$	0-05
If flowing, method of flow regulation: Valve	Other (de	escribe)	
Static Water Level: <u>33'</u> feet above			
Method of Measurement (circle one)	tape electric tape	air line other:	
Hole depth: <u>125'</u> Well depth:	125'	Well grouted to a depth of	feet
Type of grout (circle one): Cement	Bentonite Mix		
Casing length: <u>85</u> feet Casing d	liameter: <u>10</u>	_inches Type of casing: _	PVC
	liameter: <u>10</u>	inches Type of screen:	<u>PVC 160</u>
Screen slot size: <u>.050</u> inches	Setting depth: From	86 feet to <u>1</u>	<u>25</u> feet
Type of completion (circle all applicable):	ravel packed Under	reamed Telescoped Oper	hole Natural Development
Ċ	ther (describe):		
Top of lap pipe or reduction in casing:	feet. If tel	escoped or more than one sci	een, describe on back of page
\sim		Density Sonia Neutron	04
Logs run (circle all applicable): No log run	Electric Gamma Ray	Density Some Neuron	Other:
Name of organization punning log(s)		-	
Logs run (circle all applicable): No log run Name of organization running log(s): I certify that the well was drilled, constructed		-	
Name of organization running log(s): I certify that the well was drilled, construct	ed, and completed in a	eccordance with all applicable	e requirements of the Mississippi
Name of organization running log(s): I certify that the well was drilled, construct Department of Environmental Quality and/	ed, and completed in a for the Mississippi Dep	eccordance with all applicable	e requirements of the Mississippi
Name of organization running log(s): I certify that the well was drilled, construct Department of Environmental Quality and/ Irrigation Equipment	ed, and completed in a for the Mississippi Dep	eccordance with all applicable	e requirements of the Mississippi

ſ

بم ب

RECEIVED


JUL 2 1 2005 BY: OLWR If well telescopes please sketch below and show depths.

Ground Level

		•	• • •
	B-	231	
Description of Formations Encountered	From	То	
Clay	0	30	
Fine Sand	31	45	
Fine Sand/gravel	46	55	
Med. Sand	56	125	
Med. Sand/gravel	72	25	
······································			
			
		╀──┥	
		╂	
		++	
		+	
		+	

ì

If more than one screen, show location of each on sketch

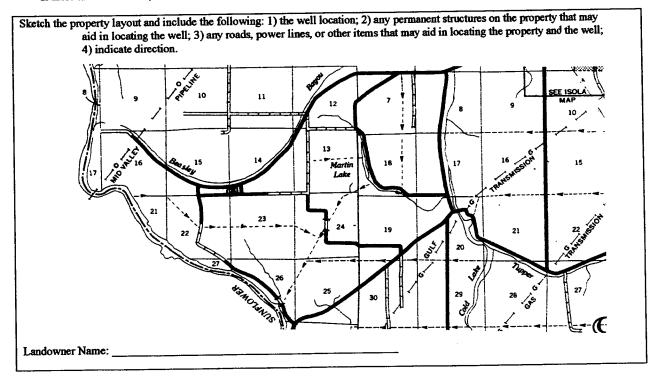

Chui æ

Signature of Water Well Contractor

	STATE WELL REPORT	
County:Humphreys	Part 2 Pump Installer's Completion Report	For Office Use Only:
Permit #: Irrigation Equipment Dnile:	Mississippi Department of Environmental Quality Office of Land and Water Resources P.O. Box 10631 Jackson, MS 39289-0631	Aquifer: Well #: <u>B ~ 231</u>
Date completed: $7 - 1 - 05$	(601)961-5210 (601)354-6938 (fax)	Elevation:

.

-

Г

This report should be prepared by the pump installer in detail and filed with the Department within 30 days of the installation of pump.

Well Owner Information	Well Location		
Owner Name: Danny Cordell	Latitude:Longitude:		
Mailing Address: 1230 Montgomery St.	Method of Lat/Long (circle one): Conventional Survey,		
Inverness, MS 38753	USGS quad, Hand-held GPS, Survey-grade GPS SW 14 SW 14 Sec 14 Twn 16N Rng 5W		
City State Zip Code 662-265-5130 Telephone No. ()	Distance Direction Nearest Town <u> <u> <u> </u> <u> </u></u></u>		
Pum p Type Circle one	Power Type Circle one		

Circle one		Circle one			
Air Lift	Jet	Submersible	Diesel Engine	Gasoline Engine	Natural Gas
Bucket	Piston	- Turbine	Electric Motor	Hend -	Tractor PTO
Centrifugal	Rotary	Flowing Well	Windmill	Other (specify):	
Other (specify):			Horse Power Rating	of Motor:10	
Date Pump Installed:	7-1-	05	Setting Depth:	70	feet
Rated Pump Capacity:	500	Gallons Per Minute	Number of Stages:	1	

Pump Test Data	Method of Measuring Water Level Circle one
Date Well Tested:	Circle one
Static Water Level (A):Feet Below Land Surface	Air Line Electric Measuring Line Steel Tape
Pumping Water Level (B):Feet Below Land Surface	Other (specify):
Drawdown [(B) - (A)]:Feet Below Land Surface	For flowing well, measured shut in head:feet
Test Pumping Rate:Gallons Per Minute	Well yieldedGPM with a drawdown of
Duration of Pump Test (minimum 4 hours):hours	feet afterhours of pumping

I HEREBY CERTIFY that the above statements are true to the best	t of my knowledge.		
Patrick M. Chism 0695	Patrick M Chin		
Print Name of Pump Installer and License No. (if applicable)	Signature of Pump Installer		
		RECE	VED

JUL 2 1 2005 BY: OLWR