	State V	Vell Report	
County: Humphreys	Part 1 Mississippi Department of Environmental Quality Office of Land and Water Resources		For Office Use Only:
Permit #: (2011/1.589			Aquifer:
Permit#: (1 (2 (1 (1 ())) /) /) / Irrigation Equipment			Well #: B-249
	1.0.	Box 10631	
Date drilling completed: $3-1-07$		MS 39289-0631)961-5210	L. S. Elevation:
		54-6938 (fax)	E-log #:
State Law requires that this rep		e driller in detail and filed w	ith the Department within
30 days of completion of drilling Well Owner Informa		Wel	Location
		33 15 29.0	N 90 37 15.8
Owner Name Bellewood	<u>d Cole Lak</u> e	Latitude:	Longitude.
Mailing Address: Box 98		Method of Lat/Long (circle or	Longitude: 37 15.8 we): Conventional Survey,
		USGS quad, Hand-held	GPS, Survey-grade GPS
Inverness	MS 38753	<u>SW 1/4 SE 1/4 Sec 5</u>	
City Stat	te Zip Code	Distance Direction	
Telephone No. () 265-520	9	2 Miles West	of <u>Isola</u>
	Well	Data	
Purpose of Well (circle one) Home Ind	untrial Dublic Sumala	End Culture	04
Date well drilling started:3-1-()7 Date	well drilling completed:3	_1_07
		U . <u> </u>	
It thousand method of them manifesters V-1			
		describe)	
Static Water Level: 25' feet ab	ove or below (circle one)	land surface Date measured:_	3-2-07
Static Water Level: <u>25'</u> feet ab Method of Measurement (circle one) st	ove or below (circle one) eel tape electric tape	land surface Date measured:	3-2-07
Static Water Level: <u>25'</u> feet ab Method of Measurement (circle one) st	ove or below (circle one) eel tape electric tape	land surface Date measured:	3-2-07
Static Water Level: $25'$ feet ab Method of Measurement (circle one) st Hole depth: 127 Well dep	ove or below (circle one) eel tape electric tape nh:127	land surface Date measured: e air line other: Well grouted to a depth of	3-2-07
Static Water Level: <u>25</u> feet ab Method of Measurement (circle one) st Hole depth: <u>127</u> Well dep Type of grout (circle one): Cement	ove or below (circle one) eel tape electric tape nh: <u>127</u> Bentonite Mix	land surface Date measured: air line other: Well grouted to a depth of	3-2-07 10 feet
Static Water Level: $25'$ feet ab Method of Measurement (circle one) st Hole depth: 127 Well dep Type of grout (circle one): Cement	ove or below (circle one) eel tape electric tape nh: <u>127</u> Bentonite Mix	land surface Date measured: air line other: Well grouted to a depth of	3-2-07 10 feet
Static Water Level: 25' feet ab Method of Measurement (circle one) st Hole depth: 127 Type of grout (circle one): Cement Casing length: 87 feet Casing	ove or below (circle one) eel tape electric tape nh: <u>127</u> Bentonite Mix	land surface Date measured: air line other: Well grouted to a depth of inches Type of casing:	3-2-07 10 feet
Static Water Level: 25' feet ab Method of Measurement (circle one) st Hole depth: 127 Type of grout (circle one): Cement Casing length: 87 Screen length: 40	eel tape electric tape th: 127 Bentonite Mix ng diameter: 16 en diameter: 16	land surface Date measured:	3-2-07 10 feet PVC Sch. 40 PVC Sch. 40
Static Water Level: 25' feet ab Method of Measurement (circle one) st Hole depth: 127 Well dep Type of grout (circle one): Cement Casing length: 87 feet Casin Screen length: 40 feet Screen Screen slot size: 050 jnches	ove or below (circle one) eel tape electric tape oth: 127 Bentonite Mix ng diameter: 16 en diameter: 16 Setting depth: From	land surface Date measured:	3-2-07 10 feet PVC Sch. 40 PVC Sch. 40 27 feet
Static Water Level: 25' feet ab Method of Measurement (circle one) st Hole depth: 127 Type of grout (circle one): Cement Casing length: 87 Screen length: 40 Screen slot size: 050	ove or below (circle one) eel tape electric tape oth: 127 Bentonite Mix ng diameter: 16 en diameter: 16 Setting depth: From	land surface Date measured:	3-2-07 10 feet PVC Sch. 40 PVC Sch. 40
Static Water Level: 25' feet ab Method of Measurement (circle one) st Hole depth: 127 Type of grout (circle one): Cement Casing length: 87 Screen length: 40 Screen slot size: 050	ove or below (circle one) eel tape electric tape oth: 127 Bentonite Mix ng diameter: 16 en diameter: 16 Setting depth: From Gavel packed Under	land surface Date measured:	3-2-07 10 feet PVC Sch. 40 PVC Sch. 40 27 feet
Static Water Level: 25' feet ab Method of Measurement (circle one) st Hole depth: 127 Type of grout (circle one): Cement Casing length: 87 Screen length: 40 feet Screet Screen slot size: 050 Type of completion (circle all applicable):	ove or below (circle one) eel tape electric tape oth: 127 Bentonite Mix ng diameter: 16 en diameter: 16 Setting depth: From	land surface Date measured:	3-2-07 10 feet PVC Sch. 40 PVC Sch. 40 27 feet
Static Water Level: 25' feet ab Method of Measurement (circle one) st Hole depth: 127 Type of grout (circle one): Cement Casing length: 87 Screen length: 40 feet Screet Screen slot size: 050 Type of completion (circle all applicable):	ove or below (circle one) eel tape electric tape oth: 127 Bentonite Mix ng diameter: 16 en diameter: 16 Setting depth: From Gavel packed Under Other (describe):	land surface Date measured:	<u>3-2-07</u> <u>10</u> <u>feet</u> <u>PVC Sch. 40</u> <u>PVC Sch. 40</u> <u>27</u> <u>feet</u> hole Natural Development
Static Water Level: 25' feet ab Method of Measurement (circle one) st Hole depth: 127 Type of grout (circle one): Cement Casing length: 87 feet Screen length: 40 feet Screen slot size: 050 inches Type of completion (circle all applicable):	ove or below (circle one) eel tape electric tape oth: 127 Bentonite Mix ag diameter: 16 en diameter: 16 Setting depth: From _ Gavel packed Unde Other (describe):feet. If te	land surface Date measured:	<u>3-2-07</u> <u>10</u> <u>feet</u> <u>PVC Sch. 40</u> <u>27</u> <u>feet</u> hole Natural Development cen, describe on back of page
Static Water Level: 25' feet ab Method of Measurement (circle one) st Hole depth: 127 Type of grout (circle one): Cement Casing length: 87 feet Screen length: 40 feet Screen slot size: 050 inches Type of completion (circle all applicable): Top of lap pipe or reduction in casing: Logs run (circle all applicable): No log run	ove or below (circle one) eel tape electric tape oth: 127 Bentonite Mix ag diameter: 16 en diameter: 16 Setting depth: From _ Gavel packed Unde Other (describe):feet. If te	land surface Date measured:	<u>3-2-07</u> <u>10</u> <u>feet</u> <u>PVC Sch. 40</u> <u>27</u> <u>feet</u> hole Natural Development cen, describe on back of page
Static Water Level: 25' feet ab Method of Measurement (circle one) st Hole depth: 127 Type of grout (circle one): Cement Casing length: 87 feet Casin Screen length: 40 050 inches Type of completion (circle all applicable): Top of lap pipe or reduction in casing: Logs run (circle all applicable): Name of organization running log(s):	ove or below (circle one) eel tape electric tape oth: 127 Bentonite Mix ag diameter: 16 en diameter: 16 Setting depth: From Gavel packed Under Other (describe): feet. If te Electric Gamma Ray	land surface Date measured:	<u>3-2-07</u> <u>10</u> feet <u>PVC Sch. 40</u> <u>27</u> feet hole Natural Development cen, describe on back of page Other:
Static Water Level: 25' feet ab Method of Measurement (circle one) st Hole depth: 127 Well dep Type of grout (circle one): Cement Casing length: 87 feet Casin Screen length: 40 feet Screet Screen slot size: .050 inches Type of completion (circle all applicable): Top of lap pipe or reduction in casing: Logs run (circle all applicable): No log run Name of organization running log(s): I certify that the well was drilled, construint	ove or below (circle one) eel tape electric tape oth: 127 Bentonite Mix ag diameter: 16 en diameter: 16 Setting depth: From Gavel packed Under Other (describe):feet. If te Electric Gamma Ray	land surface Date measured:	<u>3-2-07</u> <u>10</u> <u>feet</u> <u>PVC Sch. 40</u> <u>27</u> <u>feet</u> hole Natural Development <u>sen, describe on back of page</u> Other: <u>requirements of the Mississipp</u>
Static Water Level: 25' feet ab Method of Measurement (circle one) st Hole depth: 127 Type of grout (circle one): Cement Casing length: 87 feet Screen length: 40 feet Screen slot size: 050 inches Type of completion (circle all applicable): No log rate Cass run (circle all applicable): No log rate Name of organization running log(s): I certify that the well was drilled, constru	ove or below (circle one) eel tape electric tape oth: 127 Bentonite Mix ag diameter: 16 en diameter: 16 Setting depth: From Gavel packed Under Other (describe): feet. If te Electric Gamma Ray ucted, and completed in md/or the Mississippi De	land surface Date measured:	<u>3-2-07</u> <u>10</u> <u>feet</u> <u>PVC Sch. 40</u> <u>27</u> <u>feet</u> hole Natural Development <u>sen, describe on back of page</u> Other: <u>requirements of the Mississipp</u>
Static Water Level: 25' feet ab Method of Measurement (circle one) st Hole depth: 127 Well dep Type of grout (circle one): Cement Casing length: 87 feet Casin Screen length: 40 feet Screet Screen slot size: .050 inches Type of completion (circle all applicable): No log run Mame of organization running log(s): Icertify that the well was drilled, constru Department of Environmental Quality at Irrigation Equipment	ove or below (circle one) eel tape electric tape oth: 127 Bentonite Mix ag diameter: 16 en diameter: 16 Setting depth: From _ Gavel packed Under Other (describe): feet. If te Electric Gamma Ray ucted, and completed in nd/or the Mississippi De ent Inc.	land surface Date measured:	<u>3-2-07</u> <u>10</u> <u>feet</u> <u>PVC Sch. 40</u> <u>27</u> <u>feet</u> hole Natural Development <u>sen, describe on back of page</u> Other: <u>requirements of the Mississipp</u>
Static Water Level: 25' feet ab Method of Measurement (circle one) st Hole depth: 127 Type of grout (circle one): Cement Casing length: 87	ove or below (circle one) eel tape electric tape oth: 127 Bentonite Mix ag diameter: 16 Setting depth: From Gavel packed Unde Other (describe): feet. If te Electric Gamma Ray ucted, and completed in md/or the Mississippi De ent Inc. 0695	land surface Date measured:	<u>3-2-07</u> <u>10</u> <u>feet</u> <u>PVC Sch. 40</u> <u>27</u> <u>feet</u> hole Natural Development <u>sen, describe on back of page</u> Other: <u>requirements of the Mississipp</u>

Ł

,'

MAR 2 8 2007 BY: OLWR If well telescopes please sketch below and show depths.


Ground Level

٠

Description of Formations Encountered	From	То
Clay	0	79
Clay Med. Sand/gravel	80	127
Med. Sand/graver		
		
		ļ
		T
	_	
	<u> </u>	
		ļ
		ļ
		1

B- .

If more than one screen, show location of each on sketch

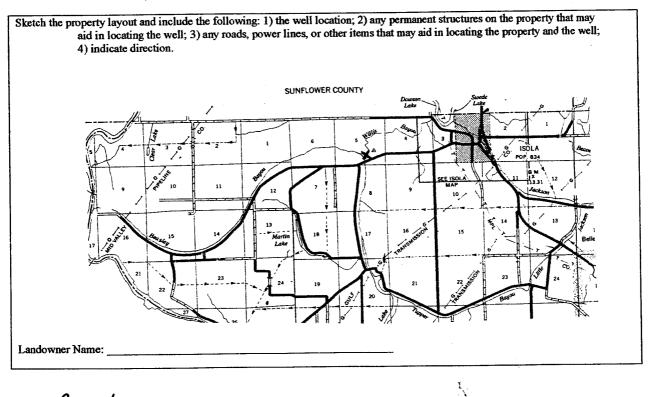

Signature of Water Well Contractor

	STATE WELL REPORT		
County: Humphreys	Part 2 Pump Installer's Completion Report	For Office Use Only:	
Permit #: (0(011589	Mississippi Department of Environmental Quality Office of Land and Water Resources	Aquifer:	
Irrigation Equipment	P.O. Box 10631 Jackson, MS 39289-0631	Well#: B- 249	
Date completed: <u>3-1-07</u>	(601)961-5210 (601)354-6938 (fax)	Elevation:	

н **Б** К 1 - Т

This report should be prepared by the pump installer in detail and filed with the Department within 30 days of the installation of pump.

Well Owner Information			Well Location	
Owner Name:	Bellewood Cole	Lake	Latitude:Longitude:	
Mailing Address:	Box 98		Method of Lat/Long (circle one): Conventional Survey,	
	Inverness MS	38753	USGS quad, Hand-held GPS, Survey-grade GPS SW SE 5 16N 4W 4 Sec Twn Rng	
	City State	Zip Code	Distance Direction Nearest Town	
	662-265-5209			
Telephone No. ()		Miles ^{West} ofIsola	
Pamp Type Circle one			Power Type Circle one	
Air Lift	Jet	ubmersible	Diesel Engine Gasoline Engine Natural Gas	

Bucket	Piston	Turbine	Electric Motor	Hand	Tractor PTO
Centrifugal	Rotary	Flowing Well	Windmill	Other (specify):	
Other (specify):			Horse Power Rating	of Motor: <u>60</u>	
Date Pump Installed:		3-2-07	Setting Depth:	70	feet
Rated Pump Capacity: _	2800±	Gallons Per Minute	Number of Stages: _	1	

Pump Test Data	Method of Measuring Water Level Circle one		
Date Well Tested:			
Static Water Level (A):Feet Below Land Surface	Air Line Electric Measuring Line Steel Tape		
Pumping Water Level (B):Feet Below Land Surface	Other (specify):		
Drawdown [(B) – (A)]:Feet Below Land Surface	For flowing well, measured shut in head:feet		
Test Pumping Rate:Gallons Per Minute	Well yielded GPM with a drawdown of		
Duration of Pump Test (minimum 4 hours):hours	feet afterhours of pumping		

I HEREBY CERTIFY that the above statements are true to the best of	f my knowledge.		
Patrick M. Chism 0695	Patrick ha	PECEI	VEn
Print Name of Pump Installer and License No. (if applicable)	Signature of Pump Installer		X has been
		MAD DO	-