

County: Humphrey  
 Permit #: GW 43146  
 Irrigation Equipment  
 Driller:  
 Date drilling completed: 4/17/09

# State Well Report

Part 1

Mississippi Department of Environmental Quality  
 Office of Land and Water Resources  
 P.O. Box 10631  
 Jackson, MS 39289-0631  
 (601)961-5210  
 (601)354-6938 (fax)

For Office Use Only:  
 Aquifer:  
 Well #: B-277  
 L. S. Elevation:  
 E-log #:

State Law requires that this report be prepared by the driller in detail and filed with the Department within 30 days of completion of drilling of the well.

Well Owner Information	Well Location
Owner Name <u>H+N Farms</u>	Latitude: " " Longitude: " "
Mailing Address: <u>Rt 1. Box 241</u>	Method of Lat/Long (circle one): Conventional Survey, USGS quad, Hand-held GPS, Survey-grade GPS
<u>Isola</u> <u>Ms.</u> <u>38754</u>	<u>NE 1/4 NE 1/4</u> Sec <u>18</u> Twn <u>16N</u> Rng <u>4W</u>
City State Zip Code	Distance Direction Nearest Town
Telephone No. ( )	<u>3</u> Miles <u>SW</u> of <u>ISOLA</u>

Well Data

Purpose of Well (circle one) Home Industrial Public Supply Irrigation Fish Culture Other: \_\_\_\_\_

Date well drilling started: 4/17/09 Date well drilling completed: 4/17/09

If flowing, method of flow regulation: Valve \_\_\_\_\_ Other (describe) \_\_\_\_\_

Static Water Level: 29 feet above of below (circle one) land surface Date measured: 4/21/09

Method of Measurement (circle one) steel tape electric tape air line other: \_\_\_\_\_

Hole depth: 126 Well depth: 126 Well grouted to a depth of 10 feet

Type of grout (circle one): Cement Bentonite Mix

Casing length: 86 feet Casing diameter: 10 inches Type of casing: PVC

Screen length: 40 feet Screen diameter: 10 inches Type of screen: PVC

Screen slot size: .050 inches Setting depth: From 87 feet to 126 feet

Type of completion (circle all applicable): Gravel packed Underreamed Telescoped Open hole Natural Development  
 Other (describe): \_\_\_\_\_

Top of lap pipe or reduction in casing: \_\_\_\_\_ feet. If telescoped or more than one screen, describe on back of page

Logs run (circle all applicable): No log run Electric Gamma Ray Density Sonic Neutron Other: \_\_\_\_\_

Name of organization running log(s): \_\_\_\_\_

I certify that the well was drilled, constructed, and completed in accordance with all applicable requirements of the Mississippi Department of Environmental Quality and/or the Mississippi Department of Health regulations and state laws.

Irrigation Equipment Inc.  
 John P. Chism 0439

Print Name of Water Well Contractor and License No.

John P. Chism  
 Signature of Water Well Contractor

RECEIVED  
 APR 24 2009  
 BY: OLWR

If well telescopes please sketch below and show depths.

B-277

Ground Level

GW43146

Description of Formations Encountered	From	To
Clay	0	18
Fine Sand	19	38
Fine Sand & Gravel	39	53
Medium Sand & Gravel	54	126

If more than one screen, show location of each on sketch

Sketch the property layout and include the following: 1) the well location; 2) any permanent structures on the property that may aid in locating the well; 3) any roads, power lines, or other items that may aid in locating the property and the well; 4) indicate direction.

Landowner Name: H + N Farms

John P. Chinn  
Signature of Water Well Contractor

RECEIVED  
APR 24 2009  
BY: OLWR

# STATE WELL REPORT

## Part 2

Pump Installer's Completion Report  
Mississippi Department of Environmental Quality  
Office of Land and Water Resources  
P.O. Box 10631  
Jackson, MS 39289-0631  
(601)961-5210  
(601)354-6938 (fax)

County: Humphrey  
Permit #: OW43146  
Irrigation Equipment  
Driller: \_\_\_\_\_  
Date completed: 4/17/09

For Office Use Only:

Aquifer: \_\_\_\_\_  
Well #: B-277  
Elevation: \_\_\_\_\_

This report should be prepared by the pump installer in detail and filed with the Department within 30 days of the installation of pump.

Well Owner Information	Well Location
Owner Name: <u>H+N Farms</u>	Latitude: _____ Longitude: _____
Mailing Address: <u>RT 1, Box 241</u>	Method of Lat/Long (circle one): Conventional Survey, USGS quad, Hand-held GPS, Survey-grade GPS
<u>Isola</u> <u>Ms.</u> <u>38754</u>	<u>NE</u> ¼ <u>NE</u> ¼ Sec <u>18</u> Twn <u>16N</u> Rng <u>4W</u>
City State Zip Code	Distance Direction Nearest Town
Telephone No. ( ) _____	<u>3</u> Miles <u>SW</u> of <u>Isola</u>

Pump Type Circle one	Power Type Circle one
Air Lift      Jet <u>Submersible</u>	Diesel Engine      Gasoline Engine      Natural Gas
Bucket      Piston      Turbine	<u>Electric Motor</u> Hand      Tractor PTO
Centrifugal      Rotary      Flowing Well	Windmill      Other (specify): _____
Other (specify): _____	Horse Power Rating of Motor: <u>15</u>
Date Pump Installed: <u>4/21/09</u>	Setting Depth: <u>70</u> feet
Rated Pump Capacity: <u>750±</u> Gallons Per Minute	Number of Stages: <u>1</u>

Pump Test Data	Method of Measuring Water Level Circle one
Date Well Tested: _____	Air Line      Electric Measuring Line      Steel Tape
Static Water Level (A): _____ Feet Below Land Surface	Other (specify): _____
Pumping Water Level (B): _____ Feet Below Land Surface	For flowing well, measured shut in head: _____ feet
Drawdown [(B) - (A)]: _____ Feet Below Land Surface	Well yielded _____ GPM with a drawdown of
Test Pumping Rate: _____ Gallons Per Minute	_____ feet after _____ hours of pumping
Duration of Pump Test (minimum 4 hours): _____ hours	

I HEREBY CERTIFY that the above statements are true to the best of my knowledge.

John P. Chism      0439  
Print Name of Pump Installer and License No. (if applicable)

John P. Chism  
Signature of Pump Installer

RECEIVED  
APR 24 2009  
BY: OLWR

H+N Farms


B-277

0043146

R 5 W

R 4 W

SUNFLOWER COUNTY

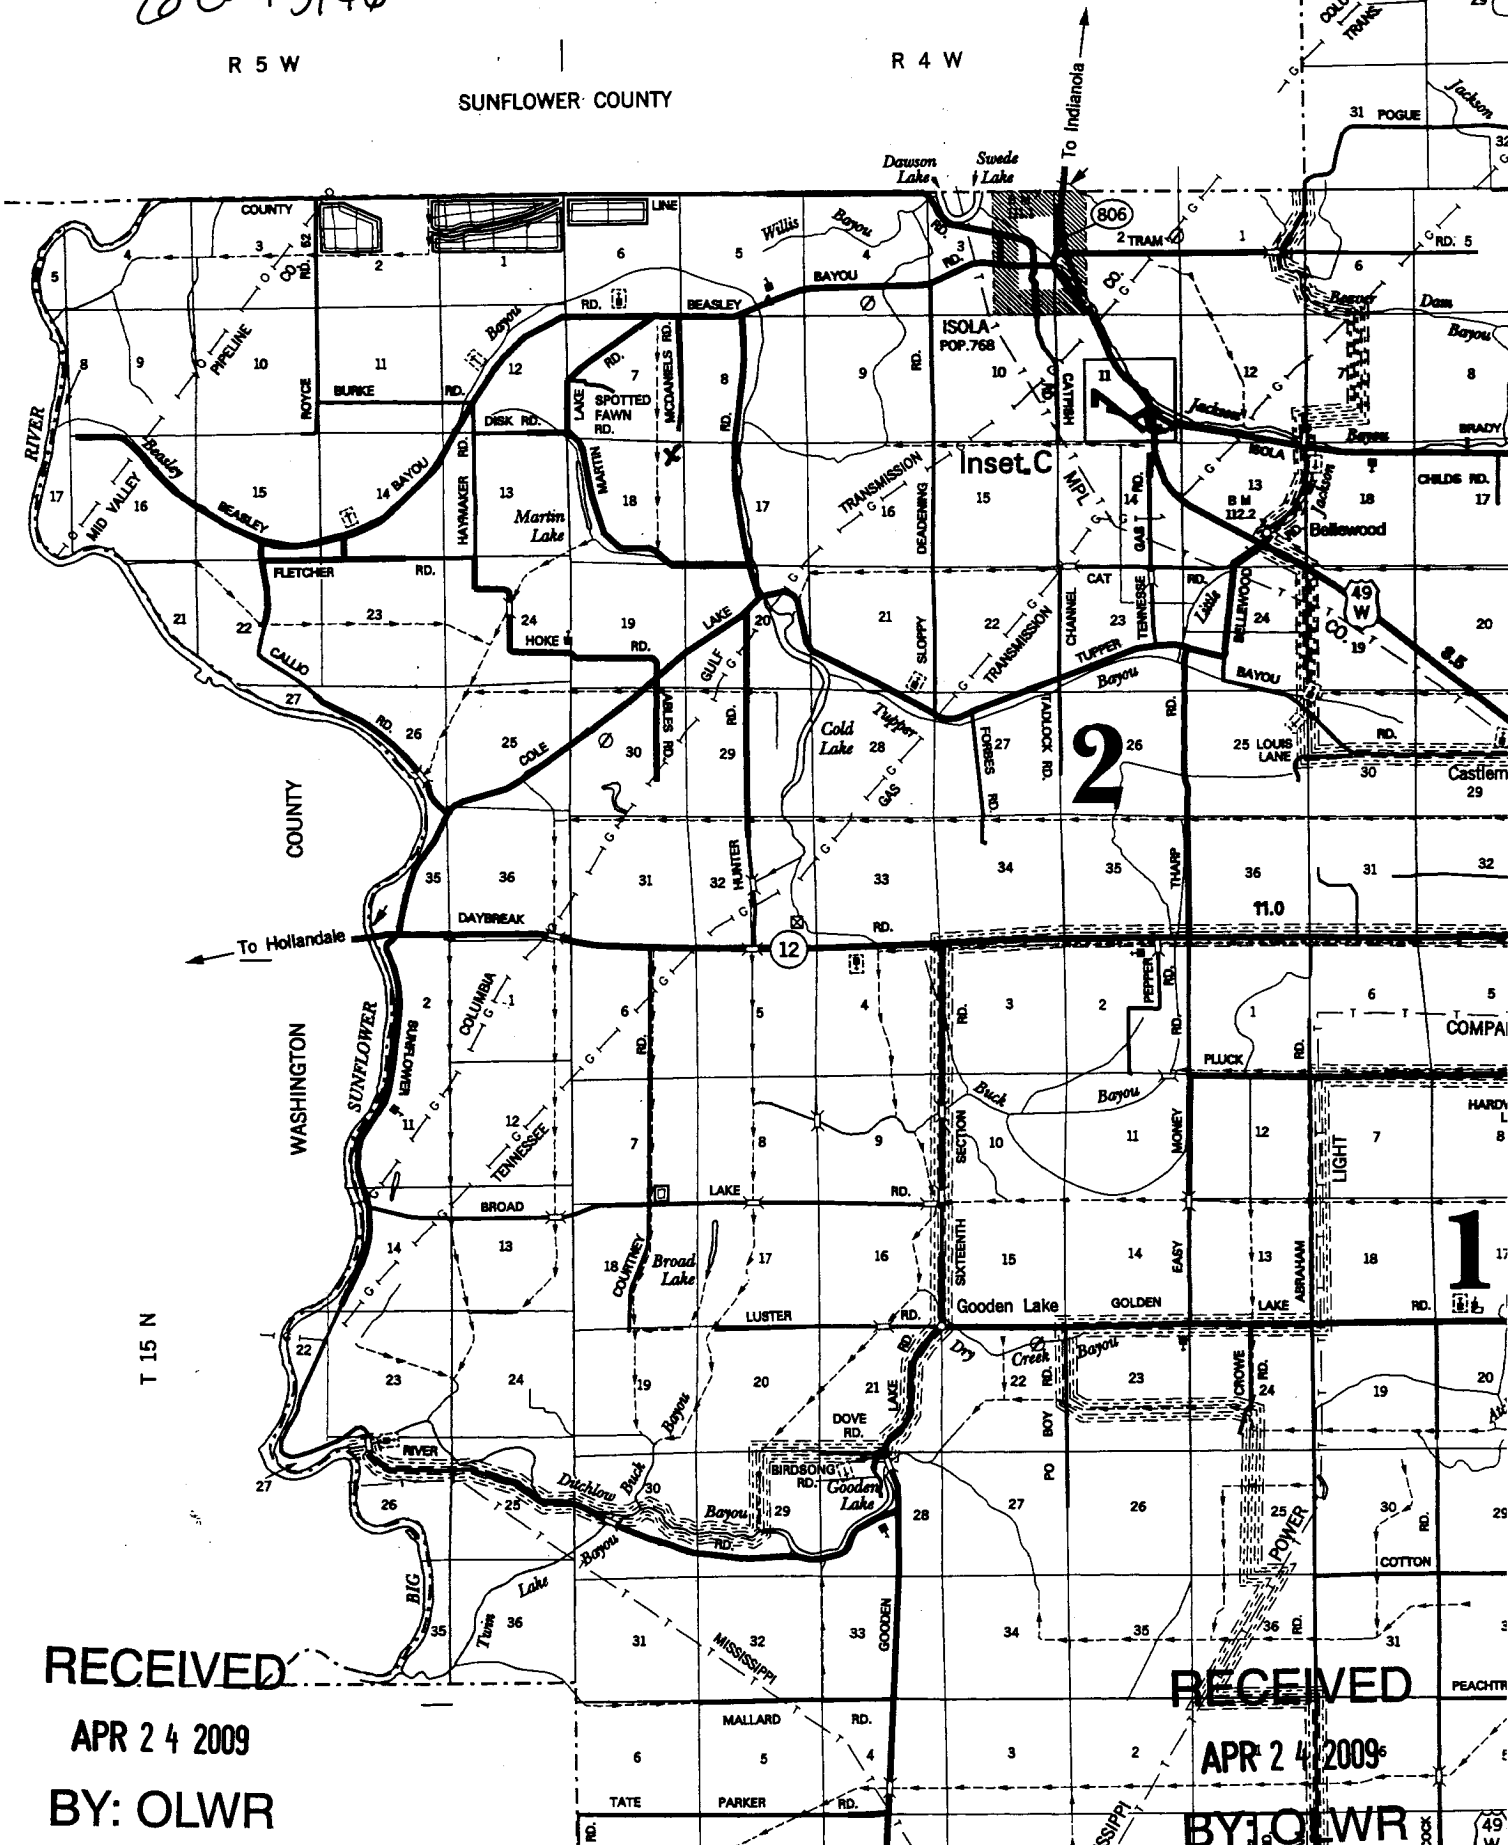

RECEIVED

APR 24 2009

BY: OLWR

RECEIVED

APR 24 2009

BY: OLWR