

County: Humphreys
 Permit #: 6W 43254
 Driller: Irrigation Equipment
 Date drilling completed: 5/30/09

State Well Report

Part 1

Mississippi Department of Environmental Quality
 Office of Land and Water Resources
 P.O. Box 10631
 Jackson, MS 39289-0631
 (601)961-5210
 (601)354-6938 (fax)

For Office Use Only:
 Aquifer: _____
 Well #: B279
 L. S. Elevation: _____
 E-log #: _____

State Law requires that this report be prepared by the driller in detail and filed with the Department within 30 days of completion of drilling of the well.

Well Owner Information	Well Location
Owner Name: <u>R + A Farms</u>	Latitude: <u>33° 14' 09"</u> Longitude: <u>90° 52' 07"</u>
Mailing Address: <u>RT 1, Box 182B</u>	Method of Lat/Long (circle one): <u>Conventional Survey</u> USGS quad, Hand-held GPS, Survey-grade GPS
<u>Isola</u> <u>Ms.</u> <u>38754</u>	<u>SE 1/4 NW 1/4</u> Sec <u>17</u> Twn <u>16N</u> Rng <u>4W</u>
City State Zip Code	Distance Direction Nearest Town <u>3</u> Miles <u>SW</u> of <u>Isola</u>
Telephone No. <u>(662) 207-0797</u>	

Well Data

Purpose of Well (circle one) Home Industrial Public Supply Irrigation Fish Culture Other: _____

Date well drilling started: 5/30/09 Date well drilling completed: 5/30/09

If flowing, method of flow regulation: Valve _____ Other (describe) _____

Static Water Level: 33 feet above or below (circle one) land surface Date measured: 6-4-09

Method of Measurement (circle one) steel tape electric tape air line other: _____

Hole depth: 126 Well depth: 126 Well grouted to a depth of 10 feet

Type of grout (circle one): Cement Bentonite Mix

Casing length: 94 feet Casing diameter: 10 inches Type of casing: PVC

Screen length: 32 feet Screen diameter: 10 inches Type of screen: PVC

Screen slot size: .050 inches Setting depth: From 95 feet to 126 feet

Type of completion (circle all applicable): Gravel packed Underreamed Telescoped Open hole Natural Development
 Other (describe): _____

Top of lap pipe or reduction in casing: _____ feet. If telescoped or more than one screen, describe on back of page


Logs run (circle all applicable): No log run Electric Gamma Ray Density Sonic Neutron Other: _____

Name of organization running log(s): _____

I certify that the well was drilled, constructed, and completed in accordance with all applicable requirements of the Mississippi Department of Environmental Quality and/or the Mississippi Department of Health regulations and state laws.

Irrigation Equipment Inc.
 John P. Chism 0439

Print Name of Water Well Contractor and License No. _____

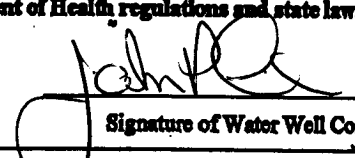
 Signature of Water Well Contractor

STATE WELL REPORT

Part 2

Pump Installer's Completion Report
 Mississippi Department of Environmental Quality
 Office of Land and Water Resources
 P.O. Box 10631
 Jackson, MS 39289-0631
 (601)961-5210
 (601)354-6938 (fax)

County: Humphreys
 Permit #: _____
 Irrigation Equipment
 Diller: _____
 Date completed: 5/30/09

For Office Use Only:

Aquifer: _____
 Well #: 18274
 Elevation: _____

This report should be prepared by the pump installer in detail and filed with the Department within 30 days of the installation of pump.


Well Owner Information	Well Location
Owner Name: <u>R + A Farms</u> Mailing Address: <u>RT 1, Box 182A</u> <u>Isola</u> <u>Ms.</u> <u>38754</u> <small>City State Zip Code</small>	Latitude: <u>33° 24' 09"</u> Longitude: <u>90° 38' 07"</u> Method of Lat/Long (circle one): Conventional Survey, USGS quad, Hand-held GPS, Survey-grade GPS. <u>SE ¼ NW ¼ Sec 17 Twn 16N Rng 4W</u> Distance Direction Nearest Town <u>3</u> Miles <u>SW</u> of <u>Isola</u>
Telephone No. <u>(662) 207-0797</u>	

Pump Type Circle one	Power Type Circle one
Air Lift Jet <input checked="" type="radio"/> <u>Submersible</u> Bucket Piston Turbine Centrifugal Rotary Flowing Well Other (specify): _____ Date Pump Installed: <u>6-4-09</u> Rated Pump Capacity: <u>550±</u> Gallons Per Minute	Diesel Engine Gasoline Engine Natural Gas <input checked="" type="radio"/> <u>Electric Motor</u> Hand Tractor PTO Windmill Other (specify): _____ Horse Power Rating of Motor: <u>10</u> Setting Depth: <u>70</u> feet Number of Stages: <u>1</u>

Pump Test Data	Method of Measuring Water Level Circle one
Date Well Tested: _____ Static Water Level (A): _____ Feet Below Land Surface Pumping Water Level (B): _____ Feet Below Land Surface Drawdown [(B) - (A)]: _____ Feet Below Land Surface Test Pumping Rate: _____ Gallons Per Minute Duration of Pump Test (minimum 4 hours): _____ hours	Air Line Electric Measuring Line Steel Tape Other (specify): _____ For flowing well, measured shut in head: _____ feet Well yielded _____ GPM with a drawdown of _____ feet after _____ hours of pumping

I HEREBY CERTIFY that the above statements are true to the best of my knowledge.

John P. Chism 0439
 Print Name of Pump Installer and License No. (if applicable)


 Signature of Pump Installer

RECEIVED
 2009 JUN 10
 10:51 AM


R+A Farms Map

R 5 W

R 4 W

SUNFLOWER COUNTY

T 17 N

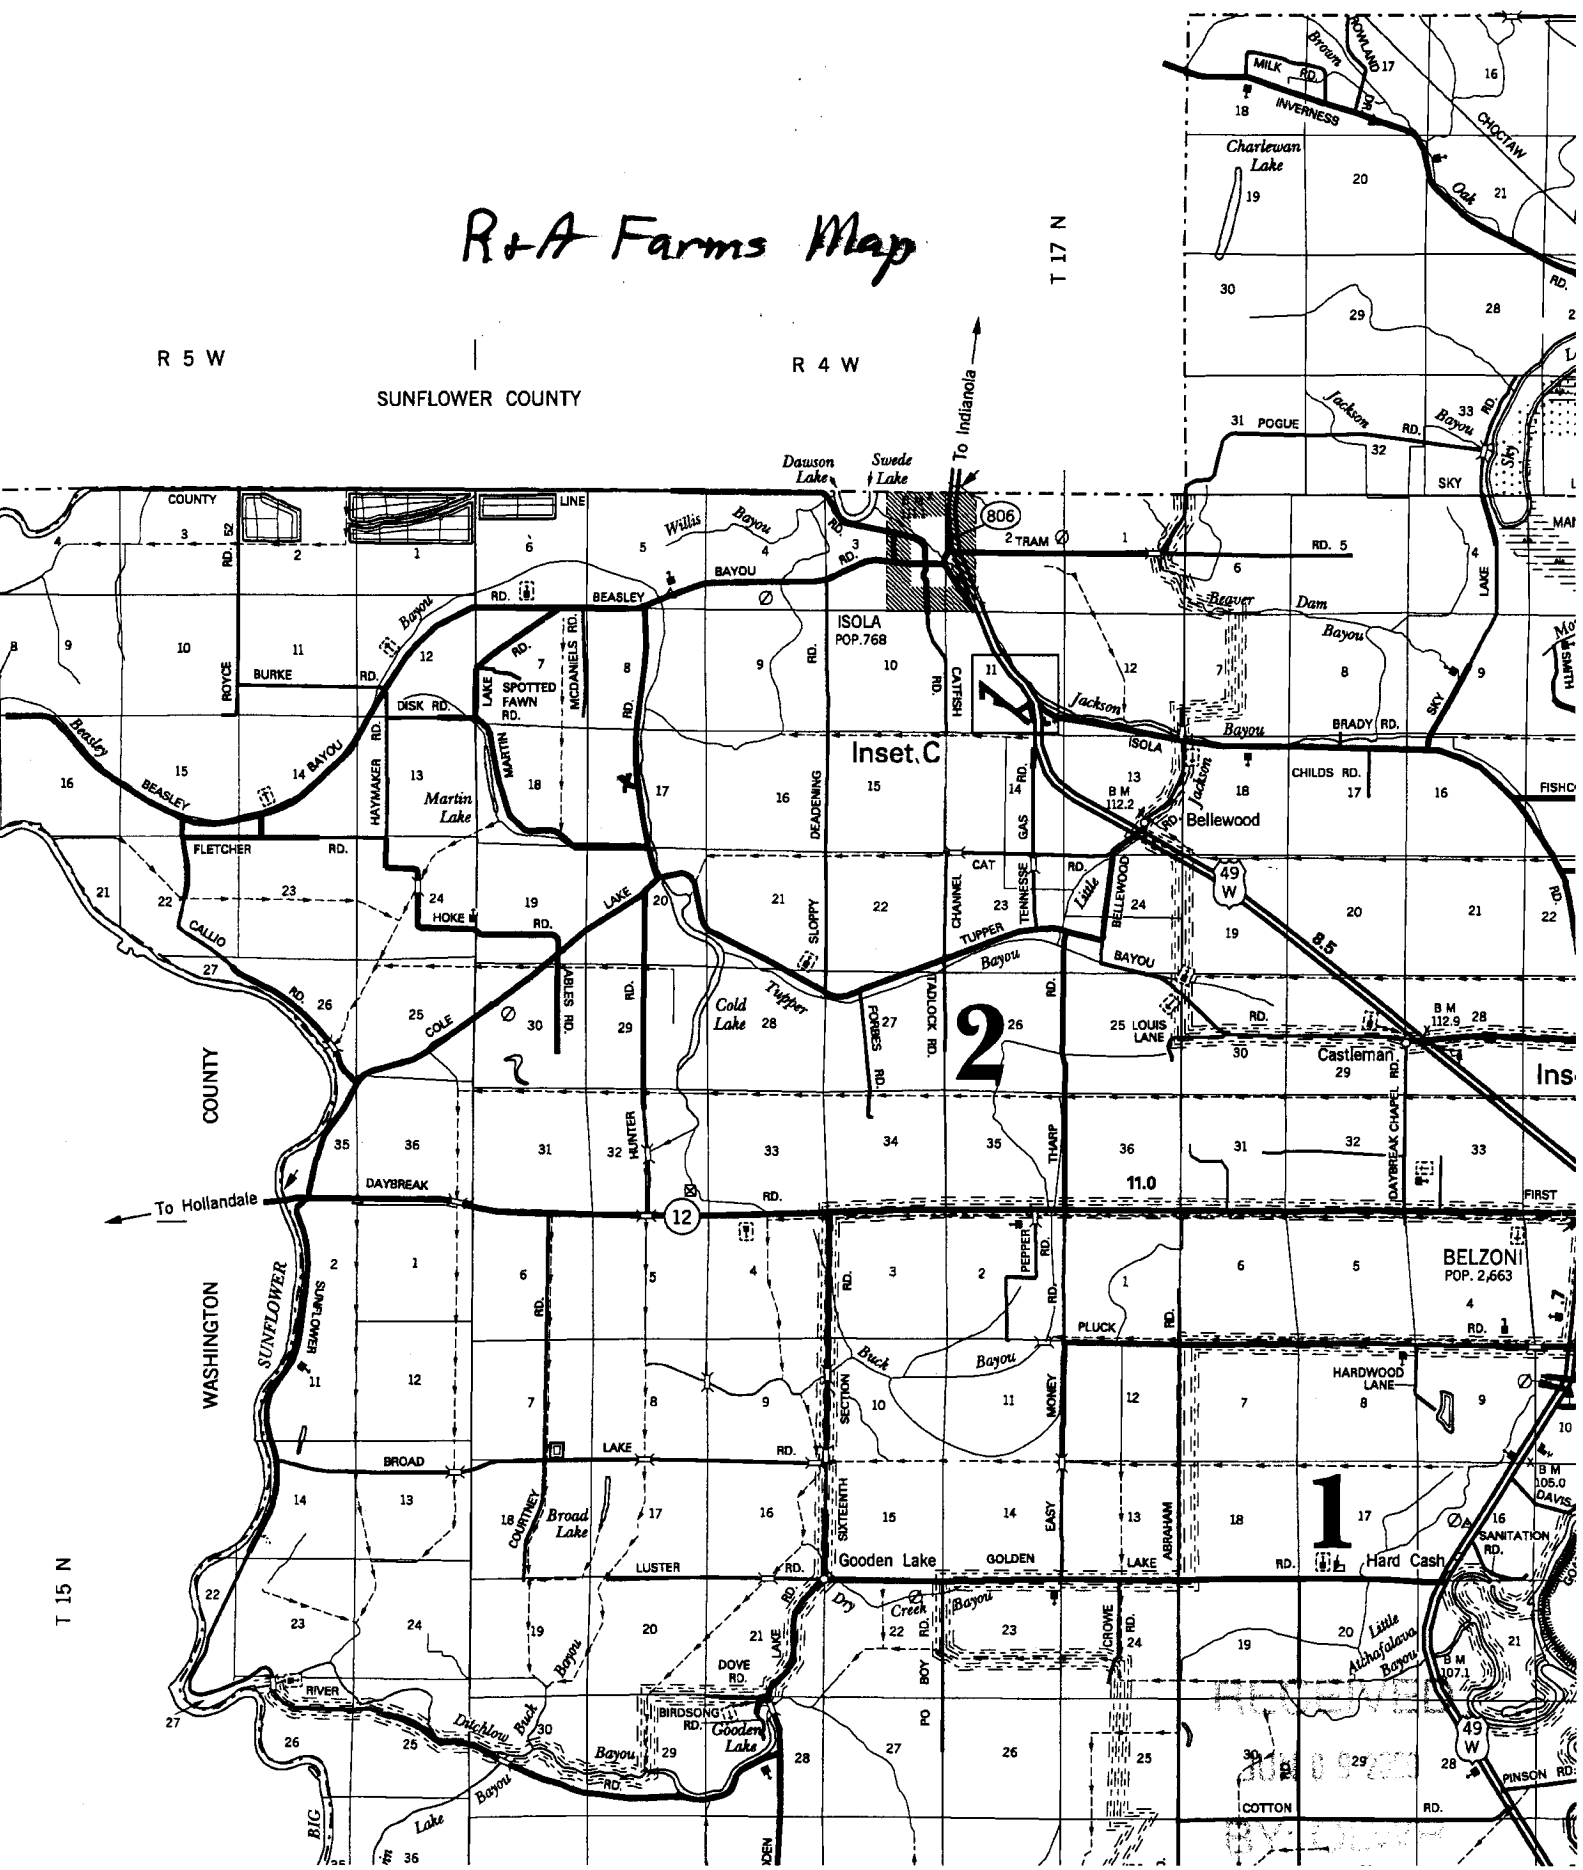

Inset C

2

1

T 15 N

WASHINGTON COUNTY

SUNFLOWER RIVER

REMO LAMIS

BROAD

COURTNEY

LUSTER

DOVE

BIRDSONG

PO

BOY

THARP

PEPPER

PLUCK

EASY

ABRAHAM

HARDWOOD LANE

SANITATION

PINSON

COTTON

DAYBREAK

DAYBREAK CHAPEL

CASTLEMAN

LOUIS LANE

TUPPER

CHANNEL

CASTISH

GAS

ISOLA

ISOLA

