

State Well Report

Part 1

County: Humphreys
Permit #: GW 43332
Irrigation Equipment
Driller: _____
Date drilling completed: 6-19-09

Mississippi Department of Environmental Quality
Office of Land and Water Resources
P.O. Box 10631
Jackson, MS 39289-0631
(601)961-5210
(601)354-6938 (fax)

For Office Use Only:
Aquifer: _____
Well #: B281
L. S. Elevation: _____
E-log #: _____

State Law requires that this report be prepared by the driller in detail and filed with the Department within 30 days of completion of drilling of the well.

Well Owner Information	Well Location
Owner Name: <u>R + A Farms</u>	Latitude: <u>33° 15' 36"</u> Longitude: <u>90° 42' 19"</u>
Mailing Address: <u>40 Robbie Forbes</u>	Method of Lat/Long (circle one): Conventional Survey,
<u>234 Jaketown Road</u>	USGS quad, Hand-held GPS, Survey-grade GPS
<u>Belzoni Ms. 39038</u>	<u>SE 1/4 SW 1/4 Sec 3 Twn 16N Rng 5W</u>
City State Zip Code	Distance Direction Nearest Town
Telephone No. <u>(662) 207-0797</u>	<u>6 Miles W of ISO19</u>

Well Data

Purpose of Well (circle one) Home Industrial Public Supply Irrigation Fish Culture Other: _____

Date well drilling started: 6-19-09 Date well drilling completed: 6-19-09

If flowing, method of flow regulation: Valve _____ Other (describe) _____

Static Water Level: 27 feet above or below (circle one) land surface Date measured: 6-20-09

Method of Measurement (circle one) steel tape electric tape air line other: _____

Hole depth: 121 Well depth: 121 Well grouted to a depth of 10 feet

Type of grout (circle one): Cement Bentonite Mix

Casing length: 81 feet Casing diameter: 16 inches Type of casing: PVC

Screen length: 40 feet Screen diameter: 16 inches Type of screen: PVC

Screen slot size: .050 inches Setting depth: From 82 feet to 121 feet

Type of completion (circle all applicable): Gravel packed Underreamed Telescoped Open hole Natural Development
Other (describe): _____

Top of lap pipe or reduction in casing: _____ feet. If telescoped or more than one screen, describe on back of page

Logs run (circle all applicable): No log run Electric Gamma Ray Density Sonic Neutron Other: _____

Name of organization running log(s): _____

I certify that the well was drilled, constructed, and completed in accordance with all applicable requirements of the Mississippi Department of Environmental Quality and/or the Mississippi Department of Health regulations and state laws.

Irrigation Equipment Inc.
John P. Chism 0439

Print Name of Water Well Contractor and License No. _____

Signature of Water Well Contractor: [Signature]

RECEIVED
JUN 29 2009
BY: OLIVE

If well telescopes please sketch below and show depths.


Ground Level

Description of Formations Encountered	From	To
Clay	0	19
Fine Sand	30	38
Fine Sand + Gravel	39	58
Medium Sand + Gravel	59	121

If more than one screen, show location of each on sketch

Sketch the property layout and include the following: 1) the well location; 2) any permanent structures on the property that may aid in locating the well; 3) any roads, power lines, or other items that may aid in locating the property and the well; 4) indicate direction.

Landowner Name: R + A Farms

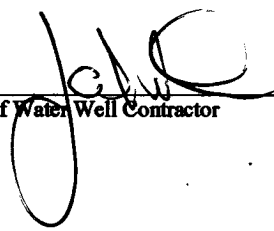
Signature of Water Well Contractor

RECEIVED
JUN 29 2009
BY: OLIVER

STATE WELL REPORT

Part 2

Pump Installer's Completion Report
 Mississippi Department of Environmental Quality
 Office of Land and Water Resources
 P.O. Box 10631
 Jackson, MS 39289-0631
 (601)961-5210
 (601)354-6938 (fax)

County: Humphreys
 Permit #: _____
 Driller: Irrigation Equipment
 Date completed: 6-19-09

For Office Use Only:

Aquifer: _____
 Well #: B281
 Elevation: _____

This report should be prepared by the pump installer in detail and filed with the Department within 30 days of the installation of pump.

Well Owner Information	Well Location
Owner Name: <u>R + A Farms</u>	Latitude: <u>33°15' 36"</u> Longitude: <u>90°42' 19"</u>
Mailing Address: <u>C/o Robbie Forbes</u> <u>234 Jaketown Road</u> <u>Belzoni Ms. 39038</u> City State Zip Code	Method of Lat/Long (circle one): Conventional Survey, USGS quad, Hand-held GPS, Survey-grade GPS <u>SE ¼ SW ¼ Sec 3 Twn 16N Rng 5W</u>
Telephone No. <u>(662) 207-0797</u>	Distance Direction Nearest Town <u>6 Miles W of Isoia</u>

Pump Type Circle one	Power Type Circle one
Air Lift Jet Submersible	<u>Diesel Engine</u> Gasoline Engine Natural Gas
Bucket Piston <u>Turbine</u>	Electric Motor Hand Tractor PTO
Centrifugal Rotary Flowing Well	Windmill Other (specify): _____
Other (specify): _____	Horse Power Rating of Motor: <u>60</u>
Date Pump Installed: <u>6-20-09</u>	Setting Depth: <u>70</u> feet
Rated Pump Capacity: <u>2800±</u> Gallons Per Minute	Number of Stages: <u>1</u>

Pump Test Data	Method of Measuring Water Level Circle one
Date Well Tested: _____	Air Line Electric Measuring Line Steel Tape
Static Water Level (A): _____ Feet Below Land Surface	Other (specify): _____
Pumping Water Level (B): _____ Feet Below Land Surface	For flowing well, measured shut in head: _____ feet
Drawdown [(B) - (A)]: _____ Feet Below Land Surface	Well yielded _____ GPM with a drawdown of _____ feet after _____ hours of pumping
Test Pumping Rate: _____ Gallons Per Minute	
Duration of Pump Test (minimum 4 hours): _____ hours	

I HEREBY CERTIFY that the above statements are true to the best of my knowledge.

John P. Chism 0439
 Print Name of Pump Installer and License No. (if applicable) Signature of Pump Installer

RECEIVED
 JUN 29 2009
 BY: OLW


R + A Farms

R 5 W

SUNFLOWER COUNTY

R 4 W

T 17 N

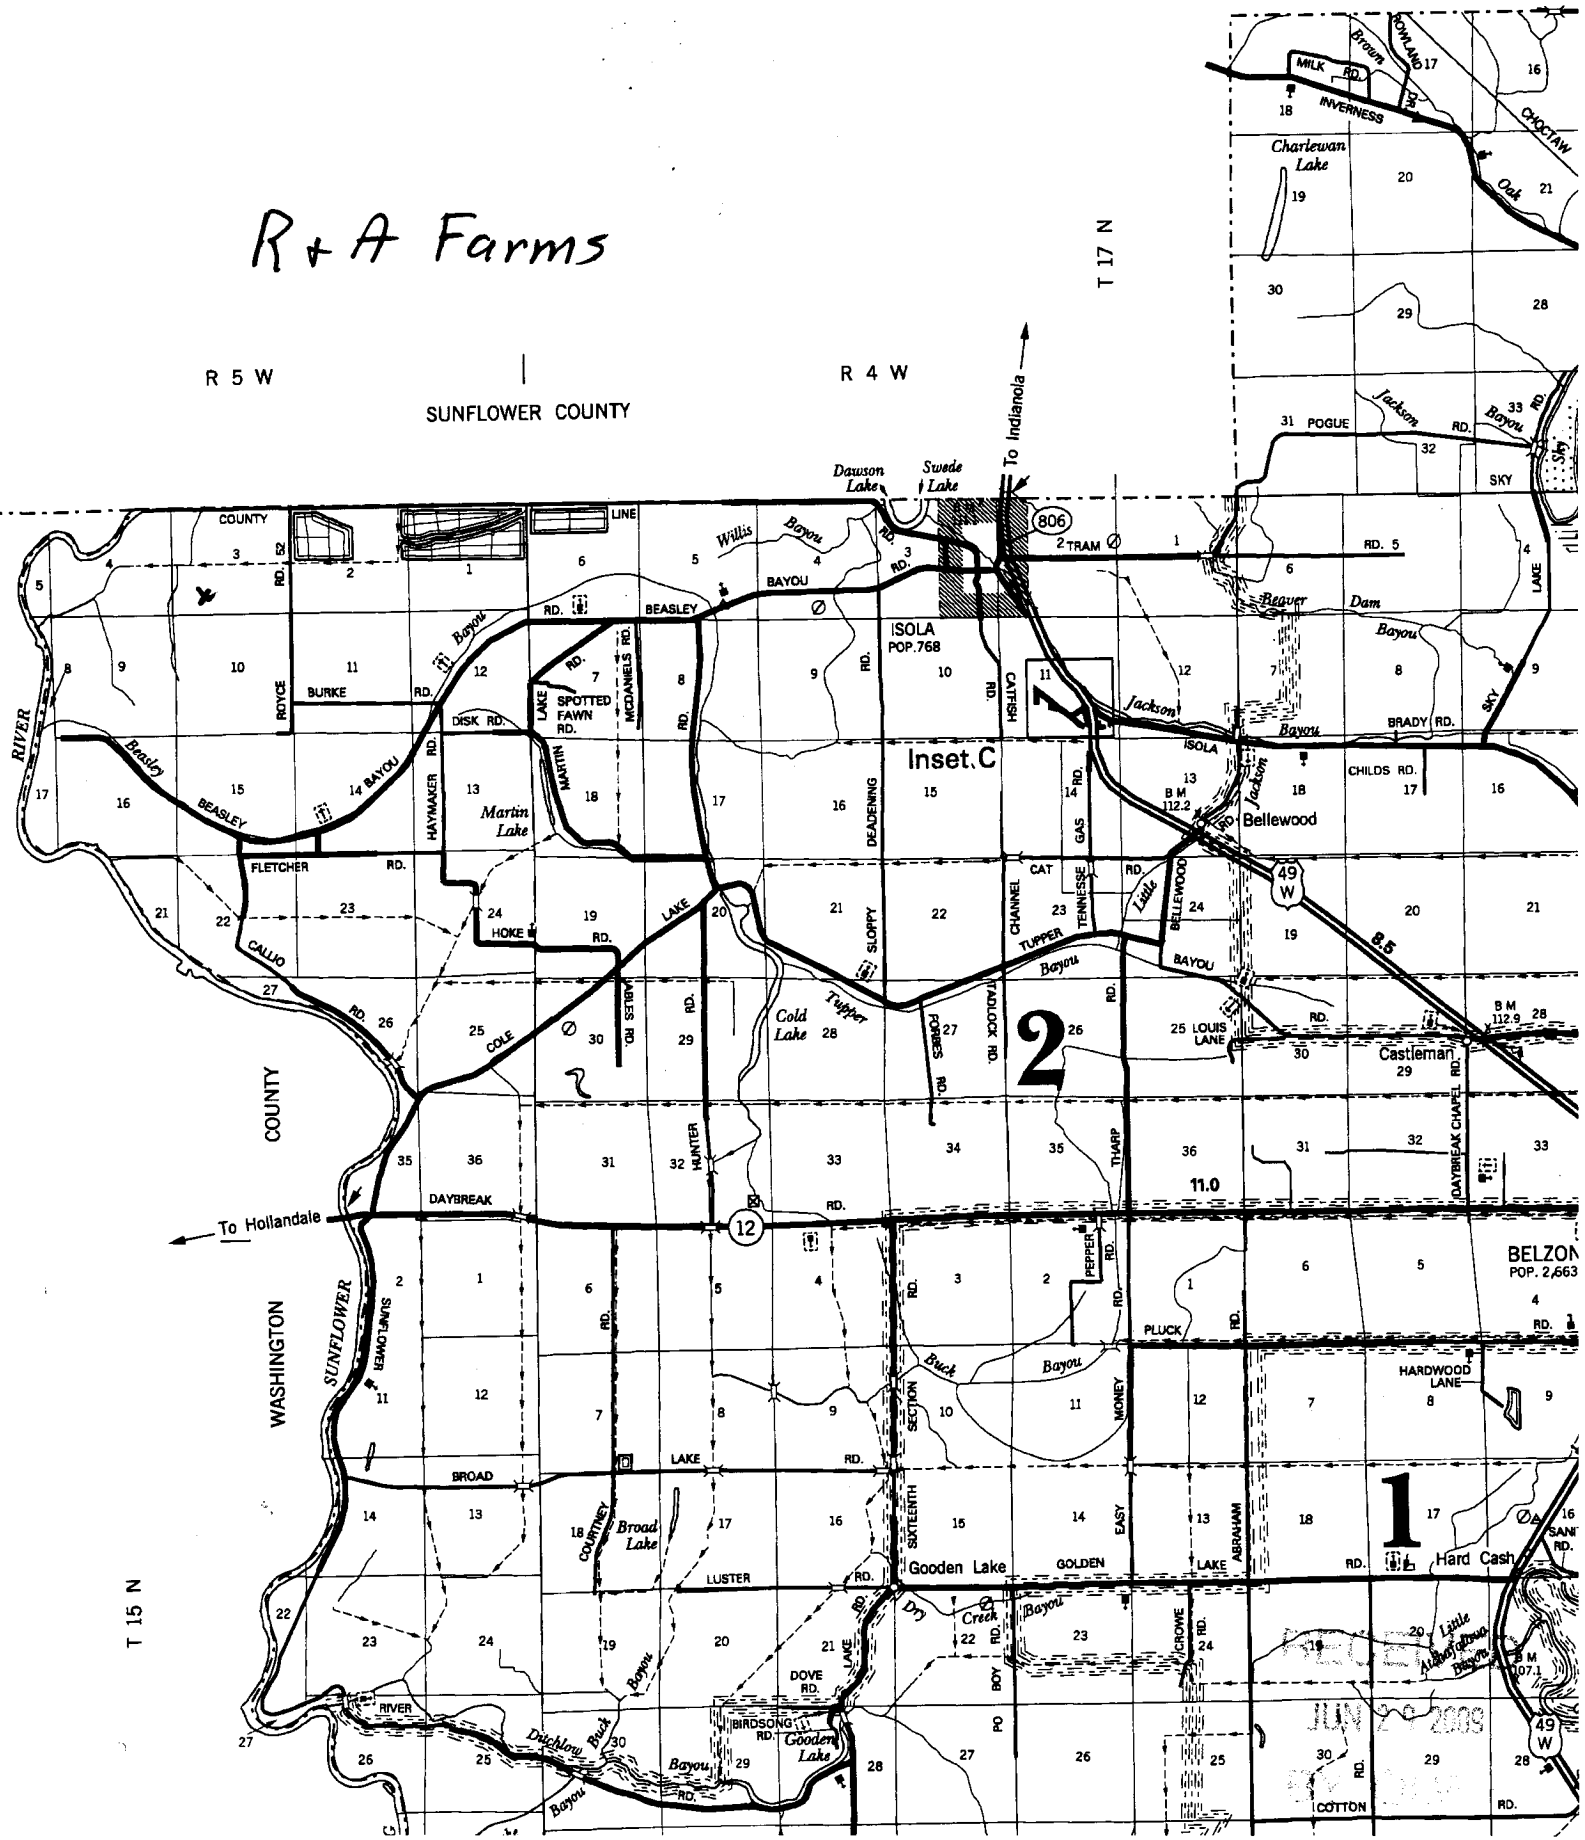

T 15 N

JUN 20 2009

BELZON
POP. 2,663

Hard Cash
RD. 16