

County: Humphreys
 Permit #: 44917
 Title: Irrigation Equipment
 Date drilling completed: 12-9-2010

State Well Report
Part 1 - Driller's Log
 Mississippi Department of Environmental Quality
 Office of Land and Water Resources
 P.O. Box 2309
 Jackson, MS 39225
 (601)961-5210
 (601)961-5228 (fax)

For Office Use Only:
 Aquifer: B 287
 Well #: _____
 L. S. Elevation: _____
 E-log #: _____

State Law requires that this report be prepared by the license holder responsible for the work and filed with the Department at the above address within 30 days of completion of drilling of the well or borehole.

<p>Information on Well Owner (Landowner if borehole is not for a water well) Bellwood Bryan Plantation Owner Name: _____ Mailing Address: <u>Box 98</u> <u>Inverness MS 38753</u> City State Zip Code <u>662-265-5209</u> Telephone No. () _____</p>	<p>Well or Borehole Location Latitude: <u>33.12, 34.5 90 33 43.7W</u> Longitude: _____ Method of Lat/Long (circle one): <u>Conventional Survey</u>, <u>USGS quad, Hand-held GPS, Survey-grade GPS</u>, <u>NW NE 1/4 Sec. 25 Twn 16N Rng 4W</u> Distance Direction Nearest Town Miles or <u>ISOLA</u></p>
---	--

Well / Borehole Data

Date drilling started: 12-9-2010 Date drilling completed: 12-9 Hole depth: 125 Hole diameter: 24"

Location of the source of any surface water used for drilling: Surface Water
 Method of dosing and volume of Chlorine used in drilling and development: 50 PPM

Logs run (circle all applicable): (No log run) Electric Gamma Ray Density Sonic Neutron Other: _____
 Name of organization running log(s): _____

Purpose of borehole (check one): Water Well Geotechnical/Geological Investigation _____ Ground Source Heat Pump _____
 Scientific Survey _____ Other (describe) _____

If drilling is not related to water well construction, skip the remainder of this block

Purpose of Well (check one): Home _____ Industrial _____ Public Supply _____ Irrigation Fish Culture _____ Replacement _____ Other: _____

If a flowing well, method of flow regulation: Valve _____ Other (describe) _____

Static Water Level: 31' feet above or below (circle one) land surface Date measured: 12-10-2010

Method of Measurement (circle one) steel tape electric tape air line other: _____

Well depth: 125 Well grouted to a depth of 10 feet Type of grout (circle one): Neat Cement (Bentonite) Mix
 Casing length: 85 feet Casing diameter: 16 inches Type of casing: pvc
 Screen length: 40 feet Screen diameter: 16 inches Type of screen: pvc
 Screen slot size: .050 inches Setting depth: From 8.5 feet to 125 feet

Type of completion (circle all applicable): Gravel packed Underreamed Telescoped Open hole Natural Development
 Other (describe): _____

Top of lap pipe or reduction in casing: _____ feet. *If telescoped or more than one screen, describe on next page*

Form: OLWR-SWR-1A (04/08)

RECEIVED
 DEC 20 2010
 BY: OLWR

County: Humphreys
 Permit #: _____
Irrigation Equipment
 Driller: _____
 Date completed: 12-9-2010
Copy information from Heck on Part 1

STATE WELL REPORT

Part 2
Pump Installer's Completion Report
 Mississippi Department of Environmental Quality
 Office of Land and Water Resources
 P.O. Box 2309
 Jackson, MS 39225
 (601)961-5210
 (601)961-5228 (fax)

For Office Use Only:

Aquifer: _____
 Well #: B287
 Elevation: _____

This part of the report must be completed by a licensed water well contractor or a licensed pump installer. A copy of Part 1 of the report must be attached and both parts filed with the Department at the above address within 30 days of well completion.

Well Owner Information	Well Location
Owner Name: <u>Bellwood Bryan Plantation</u>	Latitude: _____ Longitude: _____
Mailing Address: <u>Box 98</u>	Method of Lat/Long (check one): Conventional Survey _____
<u>Inverness MS 38753</u>	USGS quad _____, Hand-held GPS _____, Survey-grade GPS _____
City: _____ State: _____ Zip Code: _____	<u>25</u> ¹ / ₄ Sec <u>16N</u> R <u>4W</u>
Telephone No. (____) <u>662-265-5209</u>	Distance _____ Miles Direction _____ Nearest Town _____
	_____ of <u>Isola</u>

Pump Type Circle one	Power Type Circle one
Air Lift <input type="checkbox"/> Jet <input type="checkbox"/> Submersible <input type="checkbox"/>	Diesel Engine <input type="checkbox"/> Gasoline Engine <input type="checkbox"/> Natural Gas <input type="checkbox"/>
Bucket <input type="checkbox"/> Piston <input type="checkbox"/> Turbine <input checked="" type="checkbox"/>	Electric Motor <input checked="" type="checkbox"/> Hand <input type="checkbox"/> Tractor PTO <input type="checkbox"/>
Centrifugal <input type="checkbox"/> Rotary <input type="checkbox"/> Flowing Well <input type="checkbox"/>	Windmill <input type="checkbox"/> Other (specify): _____
Other (specify): _____	Horse Power Rating of Motor: <u>60</u>
Date Pump Installed: <u>12-10-2010</u>	Setting Depth: <u>70</u> feet
Rated Pump Capacity: <u>2500±</u> Gallons Per Minute	Number of Stages: <u>1</u>

Pump Test Data	Method of Measuring Water Level Circle one
Date Well Tested: _____	Air Line <input type="checkbox"/> Electric Measuring Line <input type="checkbox"/> Steel Tape <input type="checkbox"/>
Static Water Level (A): _____ Feet Below Land Surface	Other (specify): _____
Pumping Water Level (B): _____ Feet Below Land Surface	For flowing well, measured shut in head: _____ feet
Drawdown [(B) - (A)]: _____ Feet Below Land Surface	Well yielded _____ GPM with a drawdown of _____ feet after _____ hours of pumping
Test Pumping Rate: _____ Gallons Per Minute	
Duration of Pump Test (minimum 4 hours): _____ hours	

This is for (circle one): New Well Replacement of Existing Pump Repair of Existing Pump

I HEREBY CERTIFY that the above statements are true to the best of my knowledge.

Patrick M Chism 0695
 Print Name of Pump Installer and License No. (if applicable)


[Signature]
 Signature of Pump Installer

Form: OLWR-SWR-1C (07-09)

RECEIVED

DEC 20 2010

BY: OLWR

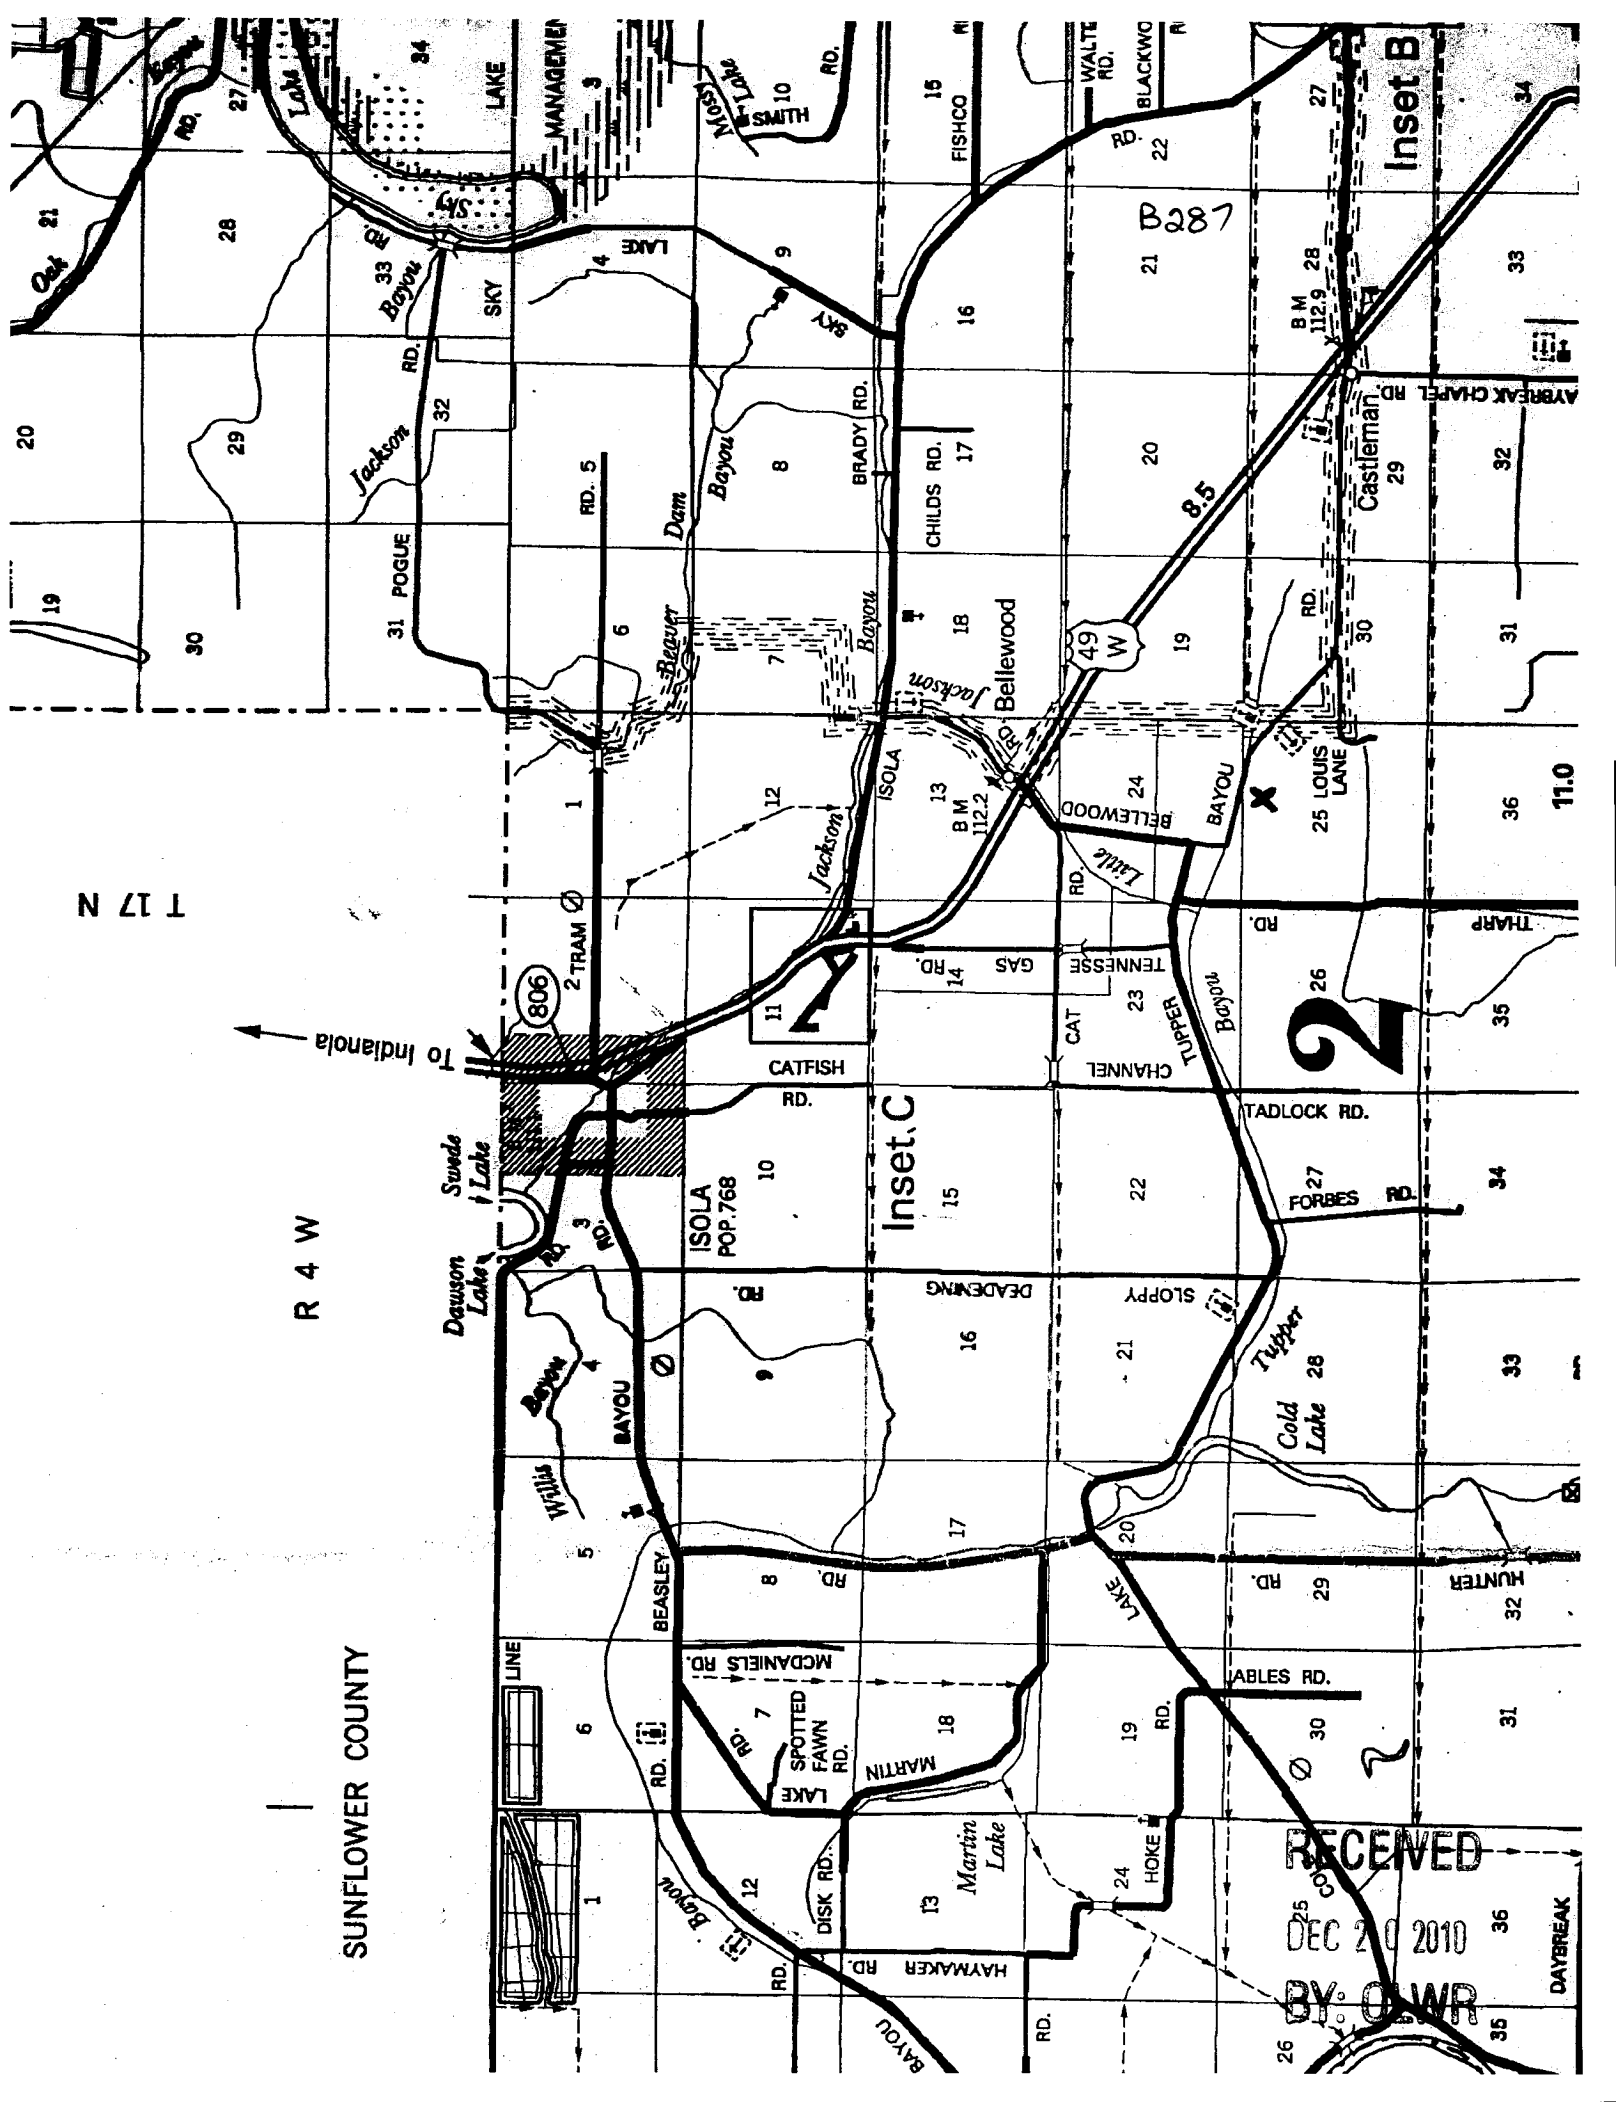

T 17 N

To Indiana

R 4 W

SUNFLOWER COUNTY



ISOLA POP. 768

Inset C

Inset B

2

RECEIVED
 DEC 20 2010
 BY: OWR

DAYBREAK