County:	Humphreys	
Permit #	GW-46986	<b>,</b>
Driller:	Irrigation Eq	uipment
Date drill	ing completed:	05/08/2013

### STATE WELL REPORT

## Part 1

Driller's Log
Mississippi Department of Environmental Quality
Office of Land and Water Resources P.O. Box 2309 Jackson, MS 39225-2309 (601) 961-5210 (601) 360-0535 (fax)

For Office Use Only: Well#: Aquifer: E-Log #:

State Law requires that this report be prepared by the license holder responsible for the work and filed with the

Department at the above address within 30 days of com	
Well Owner Information (Landowner if borehole is not for a water well)	Well or Borehole Location
Owner Name: Eagle Creek Southeast LLC	Latitude: 33 13' 23.0 N Longitude: 90 34' 06.6 W
Mailing Address: P.O. Box 98	Method of Lat/Long (check one): ☐ Conventional Survey,
	☐ USGS quad, ☑ Hand-held GPS, ☐ Survey-grade GPS
Inverness Ms 38753	SW 1/4 NW 1/4, Sec 24 T 16 N R 4 W
City State Zip code Telephone No. (662) 265-5209	2 contract
Telephone No. (662) 263-3209	2 Miles Southeast of Isola (Distance) (Direction) (Nearest Town)
Well / Bor	rehole Data
Date drilling started: 05/08/2013 Date drilling completed:	05/08/2013 Hole depth: 127 Hole diameter: 18"
	urface Water
Method of dosing and volume of Chlorine used in drilling and deve	
Logs run (check all applicable): ☑ No log run ☐ Electric ☐ Gami	
	nical/Geological Investigation
<u>_</u>	·
	Other (describe)
	struction, skip the remainder of this block
Purpose of Well (check all applicable): ☐ Home ☐ Industrial ☐ P	ublic Supply ☑ Irrigation Fish Culture
Other (describe):	
If a flowing well, method of flow regulation: Valve	Other (describe)
Static Water Level: 32 feet [⊠ above or ⊠ below (check one)	w) land surface Date measured: 05/09/2013
Method of Measurement (check one) ☒ Steel tape ☐ Electric tap	e Air line Other: (describe)
Well depth: 127 Well grouted to a depth of: 10 feet	Type of grout (check one): ☐ Neat Cement ☒ Bentonite ☐ Mix
Casing length: 87 feet Casing diameter: 10	inches Type of casing: PVC
Screen length: 40 feet Screen diameter: 10	inches Type of screen: PVC
Screen slot size: inches Setting depth:	From <u>86 8 1</u> feet to <u>127</u> feet
Type of completion (check all applicable): S Gravel packed 🗀 Un	nderreamed  Open hole  Natural Development RECEIVED
Other (describe):	neceivel
Top of lap pipe or reduction in casing: Feet	MAY <b>2 0</b> 2013
If telescoped or more than one	e screen, describe on next page
	Form: OLWR-SWE Y (4/16) LW

			For C	Office Use (	Only:	
County: Humphreys Permit #: GW-46986			Well #:			
The sketch below only required for water w	<u>ells</u>	Description of formations of and boreholes, unless speci	ncountered must be	provided for al	l wells	
I well telescopes, show depths on sketch.						
Ground level		Description of Formations		From (depth) Ground level	To (depth)	
		Clay Fine Sand		STOUTIO TEVEL	19 27	
		Fine Sand & Grave		8	52	
		Medium Sand & Gr		3	124	
		Clay		25	127	
		Oldy		LU	121	
f				· · · · · · · · · · · · · · · · · · ·		
T-F-F-F-F-F-F-F-F-F-F-F-F-F-F-F-F-F-F-F						
1						
			<del></del>			
f more than one screen, show location	of each on sketch	L.			1	
Sketch the property layout and inclu 1) the well location	de the following:					
2) any permanent structures or	the property that n	nav aid in locating the well				
		aid in locating the property and	the well			
4) a north arrow	•	,				
					İ	
					ļ	
					į	
					1	
					4	
andowner Name: Eagle Cr	eek Southeast					
			neneganian. Pakanan sangan kanan			
HEREBY CERTIFY that the well/hi	orehole was drilled	constructed and completed in a	le ditiu ecordance	Form: OLWR-SV annlicable	VR-1A (04/08)	
HEREBY CERTIFY that the well/be equirements of the Mississippi Dep	artment of Environn	nental Quality and the Miss saip	oi Department of He	ealth regulation	ns,	
and the state of t		1 (2		-	+	
	8445	<b>1</b> 00				
applicable, and state laws.  Patrick Chism  Print Name of Responsible License	0695	05/16/2013 Q	Signature of		RECEI	

MAY 2 0 2013

County:	Humphreys	
Permit #:	GW-46986	<b>;</b>
Driller:	Irrigation Eq	uipment
Date drilli	ng completed:	05/08/2013
Copy i	nformation fro	m block on Part 1

# STATE WELL REPORT

#### Part 2

# Pump Installer's Completion Report Mississippi Department of Environmental Quality Office of Land and Water Resources


P.O. Box 2309 Jackson, MS 39225-2309 (601) 961-5210 (601) 360-0535 (fax)

For Office Use Only:				
Nell #:	B318			
Aquifer:				

	report must be completed by st be attached and both parts						
j	T			_ocation			
Owner Name: _E	agle Creek Southeast LLC		Latitude:	33 13' 2	3.0 N	Longitude:	90 34' 06.6 W
Mailing Address:	P.O. Box 98		Method of	Lat/Long	(check one	): 🔲 Conv	ventional Survey,
<u>,, ., ., ., ., ., ., ., ., ., ., ., ., .</u>			Usgs	quad, 🛛 I	Hand-heid	GPS, 🔲 Sur	vey-grade GPS
inverness	Ms	38753		NW 1/	4 <b>NW</b> 1/4, S4	ec <b>24</b> T <u>16 N</u>	R4W
City	State	Zip code					<u></u>
Telephone No.	(662) 265-5209		2	Miles		ast of	Isola
			(Distanc	ce)	(Directio	n)	(Nearest Town)
	,	Pump Type	e (check one	<del>)</del>			
⊠ Submersible □	] Turbine ☐ Air Lift ☐ Centri	ifugal 🗀 Flowing W		Pieton [7]	Rotary □ (	Other (descri	ihe):
	led 05/09/2013						
=	eck one): New Repaire			Сараску.	11001/-		Gallons Per Minut
is this tump tone	ick one). 23 New Li Nepale		e (check one	9)			
☑ Electric ☐ Dies	sel 🗌 Gasoline 🗌 Natural G	as Tractor PTO	☐ Windmill	் □ Other (d	describe):		
	ng of Motor: 25						es: <u>1</u>
		B T1 B.4- 6-					
		Pump Test Data fo		_			
Date Well Tested:							Ho
	I (A): Feet Be						
Drawdown [(B) - (A	A)]: Fee	t Below Land Surfac	ce Test Po	umping Ra	nte:		_ Gallons Per Mini
Method of measur	rement (check one):   Steel	l tape 🔲 Electric tap	pe 🛮 Air line	Other	(describe):		
	The state of the s	Pump Test Data	for Flowing	g Well			
Measured shut in	head: Fe	et					
Well yielded	GPM with a dra	wdown of		feet after		hou	urs of pumping
		Meter In	stallation				
Meter Manufacture	er: Geyser		Meter S	Serial Num	ber: 0670	0693	
Meter Model Num	ber/Name: 6"		Туре	of Meter:	Propella	<u> </u>	
Totalizer Register	Unit and Multiplier Factor (A	F x .001, gal x 1000	0, etc):				
		er installed by: Irri					
Is This Meter (che	eck one): 🛛 New 🗌 Repaire						
Important: E	By submitting the above infor For agricultural	rmation you are cert l wells, a list of appr					cturer standards.
I HEREBY CERT	IFY that the above statemen	nts are true to the be	est of my kno	owledge.	I	)	
Patrick Chism	I	0695	05/	16/2013	k		2 REC
	Pump Installer and License N	lo. (if applicable)		Date		Signature o	f Pump Installer

Signature of Pump Installer
Form: OLWR-SWR-1B (4/13)

MAY 2 0 2013

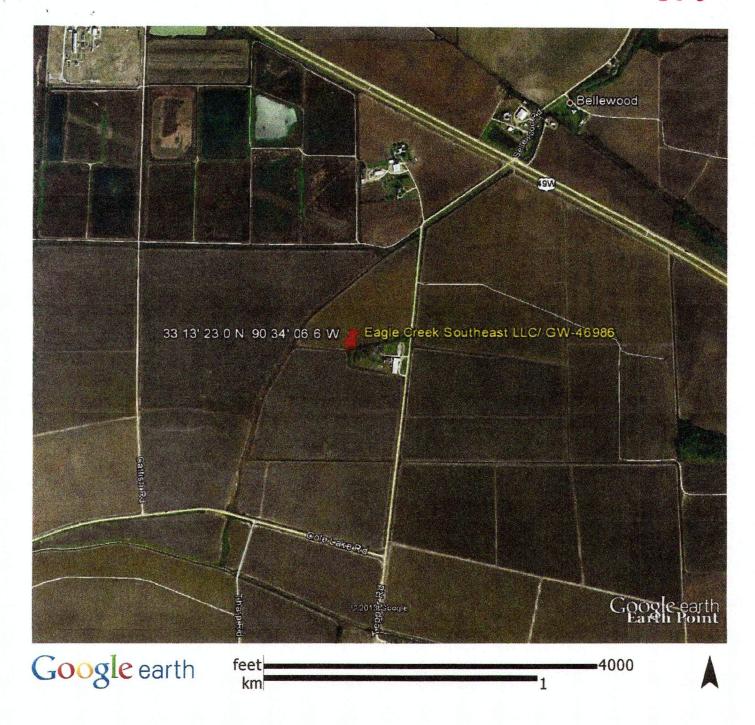

RECEIVED

MAY 2 0 2013

BY: OLWR