


HUMPHREYS MISSISSIPPI BOARD OF WATER COMMISSIONERS

C-37-16
4-17-64

WATER WELL DRILLING

CODED

RECEIVED

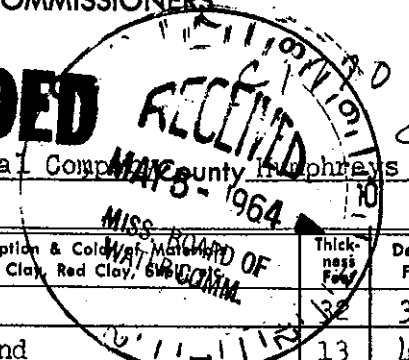

Date: April 17, 1964, Driller: Layne-Central Company Mississippi County Humphreys

(1) Owner of Land: The Delta Company
PO Box 419 (Name)
Belzoni, Mississippi
(Address)

(2) Location: 1/4, 1/4, Sec. 28 T16 N3 R3
2 1/2 miles north, of Belzoni
(distance) (direction) (Nearest Town)

(3) Topography: flat
(Hilly) (Flat) (Level)

(4) Purpose of Well: domestic
(Domestic Irrigation
Municipal, Industrial, Other)

Description & Color	Thickness Feet	Depth Feet
Clay	32	32
Fine sand	13	45
Coarse sand	26	71
Coarse sand & pea gravel	39	160
Clay	3	163
Sand	9	172
Clay & sand strks.	54	226
Fine sand & clay strks.	39	265
Clay	13	278
Clay & fine sand	35	313
Clay	27	340
Sand & clay strks.	90	430
Clay	22	452
Sand & clay strks.	24	476
Hard clay	4	480
Rock	1	481
Clay with sandy clay strks.	42	523
Hard rock	1	524
Sandy clay	7	531
Hard rock	1	532
Fine sand	13	545
Clay	25	570
Fine sand	18	588
Hard shale	47	635
Sand	13	648
Hard clay with sandy strks.	36	684
White clay	54	738
Fine sand	14	752
Sand	40	792

Information upon completion of well:

(1) Diameter 3 1/4 inches.

(2) Total Depth 792 feet.

(3) Water Level 17 feet below top of ground.
602' 3" 4"

(4) Cased to 170' 10", Size 8"
27' Lap

(5) Screen: Size 4", Length 40' 7"
4' B.P.V.

(6) Were any formations sealed against pollution?
yes yes, no no.

If YES depth of formation Lead seal,
cement plug and packer above the
screen.
Why _____

Drillers Remarks: _____

(Use Back Side)

Well No.

Mail this copy to Board of Water Commissioners 429 Miss. St. Jackson, Miss.