

HUMPHREYS MISSISSIPPI BOARD OF WATER COMMISSIONERS

C 29

2-23-62


WATER WELL DRILLERS LOG

CODED

Date: Feb 23, 1962, Driller: J. P. Minyard County Humphreys
(Name)

	Description & Color of Materials Sand, Clay, Red Clay, Shell, etc.	Thick- ness Feet	Depth Feet
(1) Owner of Land: <u>RA Roberts</u> (Name) <u>Belzoni - Miss.</u> (Address)	Soil		0-6
(2) Location: <u>1/4, 1/4, Sec. 29 T16R3</u> <u>2</u> miles <u>N</u> of <u>Belzoni</u> (distance) (direction) (Nearest Town)	Blue Clay		6-38
(3) Topography: <u>V</u> (Hilly) (Flat) (Level)	Sand		38-78
(4) Purpose of Well: <u>Domestic</u> (Domestic Irrigation Municipal, Industrial, Other)	Sand streaked with gravel		78-189
Information upon completion of well:	Sandy Shale silt/sand		189-361
(1) Diameter <u>3</u> inches. <u>3"</u> top - <u>2"</u> bottom	Sand		361-381
(2) Total Depth <u>848</u> feet.	Gumbo Brown		381-433
(3) Water Level <u>15</u> feet below top of ground. <u>413'</u> of <u>3"</u>	Fib sand Heavy streaked		
(4) Cased to <u>435'</u> , Size of <u>2"</u>	With Shale		433-546
(5) Screen: Size <u>2"</u> , Length <u>30'</u>	Shale Gumbo		546-673
(6) Were any formations sealed against pollution? <u>V</u> yes, <u>no.</u>	Sandy Shale		673-780
If YES depth of formation <u>435'</u>	Shale Gumbo Gray		780-766
Why <u>Seal off Upper Hard Water Aquifer</u>	Sandy Shale		766-818
Drillers Remarks:	Sand		818-848

CODED

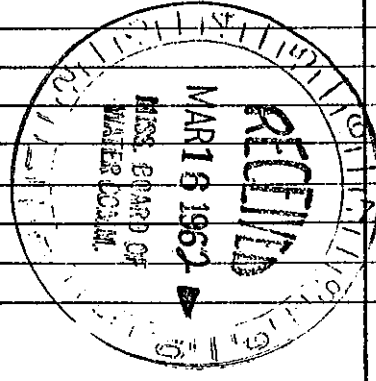

Well No.

(Use Back Side)

Mail this copy to Board of Water Commissioners 429 Miss. St. Jackson, Miss.