

HUMPHREYS MISSISSIPPI BOARD OF WATER COMMISSIONERS

C 30 GW 10434

5-7-62

WATER WELL DRILLER

CODED

117/62
1290

Date: May 7, 1962, Driller: Layne-Central Company County Humphreys

(Name)

		Description & Color of Materials Sand, Clay, Red Clay, Shell, etc.	Thick- ness Feet	Depth Feet
(1) Owner of Land: <u>The Delta Company</u> (Name)		<u>Clay</u>	<u>18</u>	<u>18</u>
<u>Belzoni, Mississippi</u> (Address)		<u>Clay balls</u>	<u>7</u>	<u>25</u>
(2) Location: <u>1/4</u> , <u>1/4</u> , Sec. <u>20</u> <u>T. 6</u> <u>R. 3</u>		<u>Hard clay</u>	<u>13</u>	<u>38</u>
<u>1/4</u> miles <u>northwest</u> , of <u>Belzoni</u> (distance) (direction) (Nearest Town)		<u>Sand</u>	<u>9</u>	<u>47</u>
(3) Topography: <u>flat</u> (Hilly) (Flat) (Level)		<u>Gummy clay</u>	<u>8</u>	<u>55</u>
(4) Purpose of Well: <u>irrigation</u> (Domestic Irrigation Municipal, Industrial, Other)		<u>Clay and sand</u>	<u>2</u>	<u>57</u>
		<u>Coarse sand</u>	<u>18</u>	<u>75</u>
		<u>Pea gravel</u>	<u>24</u>	<u>99</u>
		<u>Gravel</u>	<u>13</u>	<u>112</u>
		<u>Rock</u>		<u>112</u>

Information upon completion of well:


- (1) Diameter 16 inches.
- (2) Total Depth 112 feet.
- (3) Water Level 14' - 2" feet below top of ground.
- (4) Cased to 62', Size 16"
- (5) Screen: Size 16", Length 50'
- (6) Were any formations sealed against pollution?
 yes, No no.

If YES depth of formation _____

Why _____

Drillers Remarks: _____

CODED

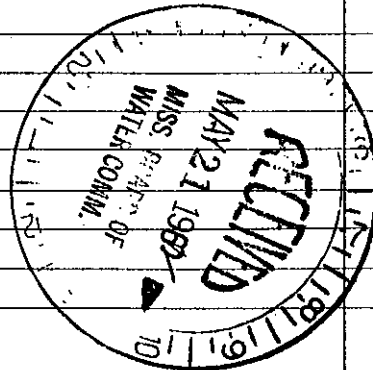

(Use Back Side)

Well No.

Mail this copy to Board of Water Commissioners 429 Miss. St. Jackson, Mis