


HUMPHREYS MISSISSIPPI BOARD OF WATER COMMISSIONERS

C 31
9-63

WATER WELL DRILLERS **CODED**

Date: Sept, 1963, Driller: David Berry County: YAZOO
(Name)

(1) Owner of Land: <u>J. D. Hale</u> (Name)	Description & Color of Materials Sand, Clay, Red Clay, Shell, etc.	Thick- ness Feet	Depth Feet
<u>Belzoni, Miss.</u> (Address)	<u>clay</u>	<u>12</u>	<u>12</u>
(2) Location: <u>1/4, 1/4, Sec. 17 T16R3</u>	<u>course sand</u>	<u>28</u>	<u>40</u>
<u>7 miles North</u> , of <u>Belzoni</u> (distance) (direction) (Nearest Town)	<u>course sand & fine gravel</u>	<u>58</u>	<u>98</u>
(3) Topography: <u>flat</u> (Hilly) (Flat) (Level)	<u>Sandy Shale</u>	<u>17</u>	<u>115</u>
(4) Purpose of Well: <u>Domestic</u> (Domestic Irrigation Municipal, Industrial, Other)	<u>pebbles</u>	<u>1</u>	<u>116</u>
Information upon completion of well:	<u>gravel</u>	<u>44</u>	<u>160</u>
(1) Diameter: <u>4 1/2</u> inches.	<u>pebbles & gravel</u>	<u>18</u>	<u>178</u>
(2) Total Depth: <u>878</u> feet.	<u>gravel</u>	<u>40</u>	<u>218</u>
(3) Water Level _____ feet below top of ground.	<u>sand</u>	<u>60</u>	<u>278</u>
(4) Cased to <u>196</u> , Size <u>4"</u>	<u>gravel</u>	<u>20</u>	<u>298</u>
(5) Screen: Size <u>2" 008</u> , Length <u>30</u>	<u>sand</u>	<u>60</u>	<u>358</u>
(6) Were any formations sealed against pollution? _____ yes, _____ no.	<u>shale</u>	<u>40</u>	<u>398</u>
If YES depth of formation _____	<u>gravel</u>	<u>20</u>	<u>418</u>
Why _____	<u>sandy shale</u>	<u>40</u>	<u>458</u>
Drillers Remarks: _____	<u>gravel</u>	<u>40</u>	<u>498</u>
_____	<u>shale</u>	<u>62</u>	<u>560</u>
_____	<u>gravel</u>	<u>40</u>	<u>600</u>
_____	<u>shale</u>	<u>40</u>	<u>640</u>
_____	<u>gravel</u>	<u>20</u>	<u>660</u>
_____	<u>sandy shale</u>	<u>130</u>	<u>790</u>
_____	<u>sand</u>	<u>80</u>	<u>878</u>

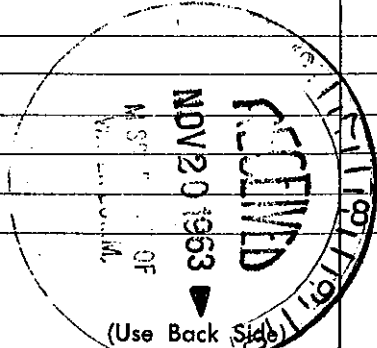

Well No. _____

Mail this copy to Board of Water Commissioners 429 Miss. St. Jackson, Mis