

CODE

BOARD OF WATER COMMISSIONERS

Humphreys

WATER WELL DRILLERS LOG

CVE

Humphreys

6-66

Date: June 9, 1966, Driller Butane Gas Co. County Efflore

(Name)

(1) Owner of Land: <u>W. E. Fuller</u> (Name)	Description & Color of Materials Sand, Clay, Red Clay, Shell, etc.	Thick- ness Feet	Depth Feet
<u>Isola, Miss.</u> (Address)	Clay	18	18
	Sand	50	68
(2) Location: <u>SW 1/4, NW 1/4, Sec. 6 T4R2</u> <u>16 3</u>	Sand & gravel	70	138
	Sand & clay st.	120	258
<u>3.8</u> miles <u>East</u> , of <u>Isola</u> (distance) (direction) (Nearest Town)	Sandy shale	167	425
	Hard shale	149	544
(3) Topography: <u>Flat</u> (Hilly) (Flat) (Level)	Sand	47	591
	Sandy shale	49	640
(4) Purpose of Well: <u>Domestic</u> (Domestic Irrigation, Municipal, Industrial, Other)	Gummy shale	72	812
	H P sand	53	865


Information upon completion of well:

- (1) Diam. 4" X 2 inches.
- (2) Total Depth 860 feet.
- (3) Water Level 14-5 feet below top of ground.
- (4) Cased to 840, Size 4" X 2"
- (5) Screen: Size 2", Length 20
- (6) Were any formations sealed against pollution?  
X  
yes, no.

If YES depth of formation \_\_\_\_\_

Why \_\_\_\_\_

Drillers Remarks: \_\_\_\_\_

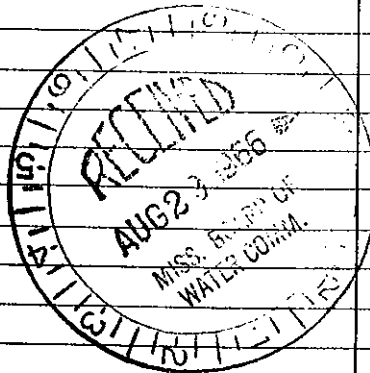

Well No.

(Use Back Side)

tain this copy for your office files.