

NEW WELL

No drill log

MILESTON QUAD

1/81 WTO

Recorded by DARDEN

Date _____

U.S. GEOLOGICAL SURVEY
WATER RESOURCES DIVISION
MISSISSIPPI DISTRICT
WELL RECORD

Well No. C73
E-Log No. _____
County HUMPHREYS

GEN. SITE DATA

Site ID 3.3.1.2.3.5.0.9.0.2.9.3.3.0.1 R=0* T=A* 2=W*

Data reliab. 3=C* Report. agency 4=USGS* Dist. 6=28* 7=28* Co. 8=0.5.3*

Lat. Long. 9=3.3.1.2.3.5.* 10=0.9.0.2.9.3.3.* Well No. 12=C73*
Location 13=N.E.N.E.S.2.7.T.1.6.N.R.0.3.W.* Alt. 16=1.1.0.*

Hyd. Unit (OWDC) 20= _____* Date 21=0.9.1.2.3.1.1.9.8.2.*

Well use 23=W.* Water Use 24=I.* Hole depth 27= _____* Well depth 28=1.1.0.*

WL 30=3.1.* Date 31=0.9.1.2.3.1.1.9.8.2.* Source 33=S.*

Status 273= _____* Project No. 5= _____*

50.06 9-23-
14.43
35.57
5.00 MP
30.57

MP = DISC PIPE = 6.00

OWNER

R=158* T=A* Date 159# 0.9.1.2.3.1.1.9.8.2.* Owner No. _____

Owner 161# V.N.K.N. & W.N.

FIELD QW

R=192* T=A* Date 193# 1.1.1.* Temp. 196#00010* 197= _____*

R=192* T=A* Date 193# 1.1.1.* Cond. 196#00095* 197= _____*

R=192* T=A* Date 193# 1.1.1.* pH 196#00400* 197= _____*

CONSTR.

R=58* T=A* 59# 1* Date 60# 0.9.1.2.3.1.1.9.8.2.* Remarks _____

Drlg. 63= _____* Name _____ Method 65# R.* Finish 66# S.*

GREEN PUMP DIESE FUEL

CASING

R=76* T=A* 59# 1*

Top csng. 77# 0.* Bot. csng. 78= _____* Diam. 79# 1.6.*

R=76* T=A* 59# 1*

Top csng. 77# _____* Bot. csng. 78= _____* Diam. 79# _____*

OPENINGS

R=82* T=A* 59# 1* Top 83# _____* Bottom 84= _____*

Type 85= _____* Diam. 87= _____* Size 88= _____*

R=82* T=A* 59# 1* Top 83# _____* Bottom 84= _____*

Type 85= _____* Diam. 87= _____* Size 88= _____*

YIELD

R= _____* T=A* 147# 1* Q 150= _____* Q/S 272= _____*

134 flows 146 pumped

LIFT

R=42* T= A * Lift type 43# 7* Intake 44=1* Power type 45= D*
Date 38= 0,9,12,3,1,1,9,8,2* H.P. 46=1*

LOGS

R=198* T= A * Log 199# 1* Top 200=1* Bot 201=1*
R=198* T= A * Log 199# 1* Top 200=1* Bot 201=1*
R=189* T= A * E Log No. 190# 1* 191= M I S S I S S I D I S T *

ANAL.


R=114* T= A * Year 115# 1* 117=1* 120=1*

AQUIFERS

R=90* T= A * 256# 1* Top 91=1* Bot 92=1*
Unit ID 93= 1,1,2,MRVA* Name of Unit
R=90* T= A * 256# 1* Top 91=1* Bot 92=1*
Unit ID 93= Name of Unit


HYDRAULICS

R=98* T= A * 99# 1* Unit tested 100=1*
R=105* T= A * 99# 1* Test No. 106# 1*
107= Transmissivity (gal/d)/ft
108= Hydraul. cond. (gal/d)/ft²
110= Storage coeff. Boundaries

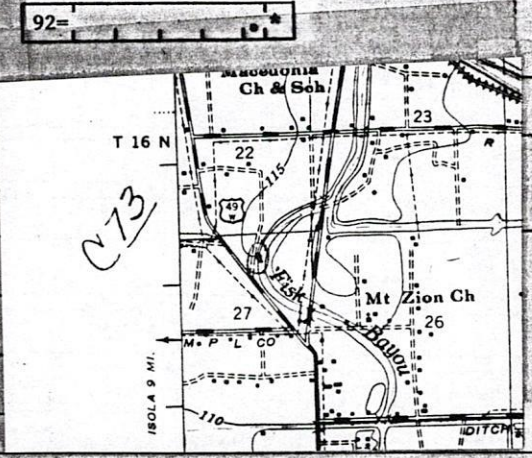

R=121* T= A * Yr Begin 122# 1,9,8,2* Network 258# 1*

Water Level Data Collection (1)

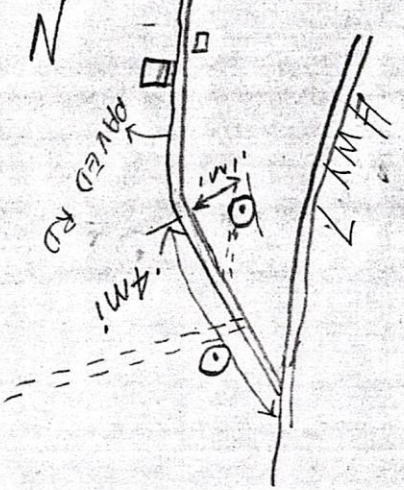

MISSISSIPPI DEPARTMENT OF ENVIRONMENTAL QUALITY
Office of Land and Water Resources
 P. O. Box 2309
 Jackson, MS 39225
Water Well Plugging/Decommissioning Form
OLWR-DF-1 (04/08)
 (601)961-5555 (601)961-5228 (fax)

33.21106
 90.49372

COUNTY WELL LOCATED: <u>Humphreys</u>		WELL NUMBER: <u>C73</u>
PERMIT NUMBER: <u>GW-10075</u>	DATE WELL PLUGGED: <u>4/1/2019</u>	
NAME OF FIRM PLUGGING WELL: <u>Irrigation Equipment Inc.</u>		TELEPHONE NUMBER: <u>662-887-2555</u>
NAME AND ADDRESS OF CURRENT LANDOWNER:		
WELL LOCATION: <u>NW/NE</u> SECTION: <u>27</u> TOWNSHIP: <u>16N</u> RANGE: <u>3W</u>		
WELL LOCATION: LATITUDE: <u>33-12-39.8W</u> LONGITUDE: <u>90-29-37.4W</u>	METHOD (Check ONE): <input type="checkbox"/> USGS QUAD <input type="checkbox"/> CONVENTIONAL SURVEY <input type="checkbox"/> GPS - HAND HELD OR SURVEY GRADE	
DISTANCE: _____ DIRECTION: _____	NEAREST TOWN: <u>Belzoni</u> OTHER LANDMARK: _____	
WELL PURPOSE (HOME, IRRIGATION, MUNICIPAL, ETC.): <u>Irrigation</u>		
NAME OF WELL CONTRACTOR WHO DRILLED THE WELL:		
NAME OF LANDOWNER WHEN WELL WAS DRILLED:		

WELL DATA			
WELL DEPTH: <u>111'</u>	HOLE DEPTH:		
CASING DIAMETER (IN.): <u>16"</u>	CASING LENGTH (FT.): _____	TYPE OF CASING: <u>Steel</u>	
DEPTH TO STATIC WATER LEVEL: <u>28'</u>	DATE WELL COMPLETED:		
WHY IS THE WELL BEING ABANDONED?			

DESCRIBE HOW THE WELL OR HOLE WAS PLUGGED (AMOUNT OF CASING AND/OR SCREEN THAT WAS REMOVED OR LEFT IN HOLE, MATERIAL AND AMOUNT USED IN PLUGGING, METHOD OF PLACING MATERIAL, ETC.) <u>Removed casing below ground level. Installed 5% chlorine bleach. Installed sand and gravel. Installed bentonite hole plug.</u>

RECEIVED
 APR 15 2019
 BY OLWR

I CERTIFY THAT THE WELL WAS PLUGGED OR ABANDONED IN ACCORDANCE WITH THE STATE OF MISSISSIPPI REGULATIONS.	
<u>Patrick M Chism</u> PRINT NAME	<u>0695</u> MS LICENSE NUMBER
<u>[Signature]</u> SIGNATURE	<u>4/11/19</u> DATE