

MISSISSIPPI DEPARTMENT OF NATURAL RESOURCES

Bureau of Land and Water Resources

Southport Mall

P.O. Box 10631

Jackson, Mississippi 39209

WATER WELL DRILLERS LOG


Humphreys  
C 122

CODED

June 16 1985 Lamp Well's pump Humphreys  
Date well completed Firm name County well located

LANDOWNER: <u>S. R. McClintock</u>	description of formations encountered	from	to
<u>Belzoni mo.</u> (mailing address)	<u>CLAY</u>	<u>0</u>	<u>30</u>
	<u>&amp; FINE SAND</u>	<u>30</u>	<u>50</u>
	<u>COARSE SAND + GRAVEL</u>	<u>50</u>	<u>108</u>
<p>WELL LOCATION:</p> <p>sec. <u>6</u> T. <u>16</u> N R. <u>3</u> E S W</p> <p><u>3</u> miles <u>E</u> of <u>Isola</u> (distance) (direction) (nearest town)</p>			
<p>WELL PURPOSE: (home, irrigation, municipal, industrial)</p>			
<p>WELL COMPLETION DATA:</p>			
(1) diameter (inches) <u>12"</u>			
(2) total depth (feet) <u>108'</u>			
(3) static water level (feet) <u>26</u> below above top of ground.			
(4) casing <u>Steel</u> , <u>68'</u> (material) (depth)			
(size) If telescope see back.			
(5) screen <u>40'</u> , <u>68'</u> (length) (depth to top)			
<u>12'</u> , <u>Steel</u> (size) (material)			
(6) pump <u>60</u> , <u>1200</u> (HP) (yield gpm)			
<u>D</u> (type power)			
(7) electric log <u>No</u> (yes or no)			
(organization running log)			
(8) how well bottom plugged <u>Steel Plate</u>			
DRILLERS REMARKS:			

CODED

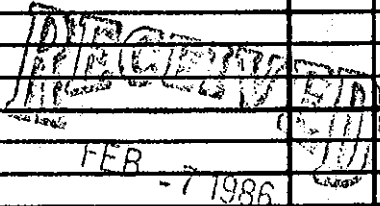

Department of Natural Resources  
Bureau of Land & Water Resources