

MISSISSIPPI DEPARTMENT OF NATURAL RESOURCES P

Bureau of Land and Water Resources

Southport Mall

P.O. Box 10631

Jackson, Mississippi 39209

WATER WELL DRILLERS LOG

Humphreys
C126
5-6-85

CODED

May 06
date well completed

1985 Lampy Well & Pump
firm name

Humphreys
county well located

LANDOWNER: John Allen Jones

description of formations encountered

from

to

Belzoni, MS.
(mailing address)

<u>clay</u>	<u>0</u>	<u>24</u>
<u>Fine sand</u>	<u>24</u>	<u>45</u>
<u>Coarse sand & gravel</u>	<u>45</u>	<u>106</u>

WELL LOCATION:

sec. 31 T. 16 N R. 3 E
S 4 W
4 miles (distance) W (direction) of Belzoni (nearest town)


WELL PURPOSE:

(home, irrigation, municipal, industrial)

WELL COMPLETION DATA:

- (1) diameter (inches) 12"
- (2) total depth (feet) 106'
- (3) static water level (feet) 22' below top of ground.
- (4) casing Steel 66'
(material) (depth)
(size) If telescope see back.
- (5) screen 40' 66'
(length) (depth to top)
12" Steel
(size) (material)
- (6) pump 40 2000
(HP) (yield gpm)
L.P.
(type power)
- (7) electric log NO
(yes or no)

CODED

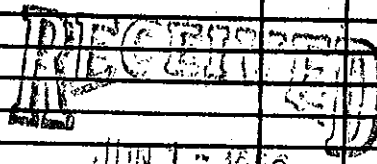

Department of Natural Resources
Bureau of Land & Water Resources

(organization running log)

(8) how well bottom plugged Steel Plate

DRILLERS REMARKS: