

# State Well Report

## Part 1

Mississippi Department of Environmental Quality  
Office of Land and Water Resources  
P.O. Box 10631  
Jackson, MS 39289-0631  
(601)961-5210  
(501)354-6938 (fax)

For Office Use Only:

Aquifer: \_\_\_\_\_  
Well #: C-158  
L. S. Elevation: \_\_\_\_\_  
E-log #: \_\_\_\_\_

County: Humphreys  
Permit #: GW40160  
Driller: mat [unclear]  
Date drilling completed: 4-23-05

State Law requires that this report be prepared by the driller in detail and filed with the Department within 30 days of completion of drilling of the well.

Well Owner Information	Well Location
Owner Name: <u>Rod Rodgers</u>	Latitude: <u>33° 15' 05" N</u> Longitude: <u>090° 31' 07" W</u>
Mailing Address: <u>RR 2 Box 30</u>	Method of Lat/Long (circle one): Conventional Survey,
<u>Belzoni</u> MS <u>39038</u>	USGS quad, <u>(Hand-held GPS)</u> Survey-grade GPS
City State Zip Code	<u>SW 1/4 NW 1/4 Sec 9</u> ✓ Twn <u>17 N</u> Rng <u>3 W</u>
Telephone No. <u>(662) 247-3778</u>	Distance Direction Nearest Town
	<u>3.5 Miles NE</u> of <u>Belzoni, MS</u>

**RECEIVED**  
**APR 29 2005**  
**BY: OLWR**

**Well Data**

Purpose of Well (circle one) Home Industrial Public Supply Irrigation Fish Culture Other: \_\_\_\_\_

Date well drilling started: 4-23-05 Date well drilling completed: 4-23-05

If flowing, method of flow regulation: Valve N/A Other (describe) \_\_\_\_\_

Static Water Level: 25 feet above or below (circle one) land surface Date measured: 4-25-05

Method of Measurement (circle one) steel tape electric tape air line other: \_\_\_\_\_

Hole depth: 120 Well depth: 120 Well grouted to a depth of 10 feet

Type of grout (circle one): Cement Bentonite Mix

Casing length: 80 feet Casing diameter: 16 inches Type of casing: SCH 40 PVC

Screen length: 40 feet Screen diameter: 16 inches Type of screen: SCH 40 PVC

Screen slot size: 22 inches Setting depth: From 80 feet to 120 feet

Type of completion (circle all applicable): Gravel packed Underreamed Telescoped Open hole Natural Development

Other (describe): \_\_\_\_\_

Top of lap pipe or reduction in casing: N/A feet. If telescoped or more than one screen, describe on back of page

Logs run (circle all applicable): No log run Electric Gamma Ray Density Sonic Neutron Other: N/A

Name of organization running log(s): \_\_\_\_\_


I certify that the well was drilled, constructed, and completed in accordance with all applicable requirements of the Mississippi Department of Environmental Quality and/or the Mississippi Department of Health regulations and state laws.

Robert Byars \_\_\_\_\_  
Print Name of Water Well Contractor and License No. Signature of Water Well Contractor

If well telescopes please sketch below and show depths.

C-158

Ground Level

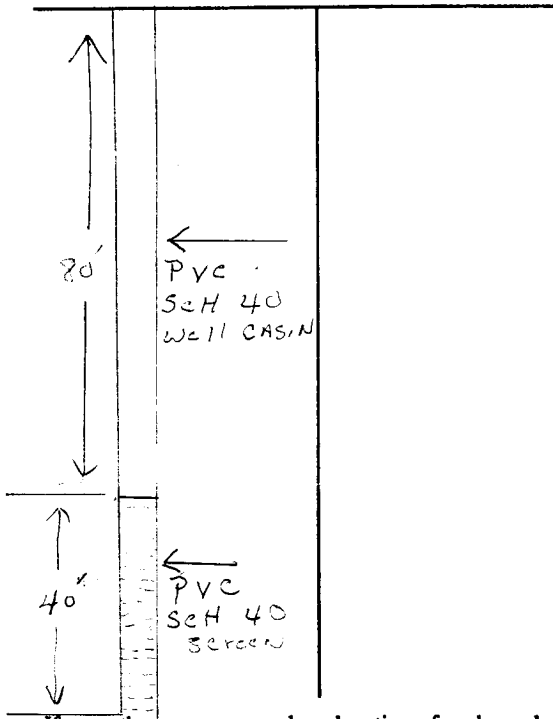

Description of Formations Encountered

From To

Description of Formations Encountered	From	To
CLAY	0	16
FINE SAND	16	40
Med SAND	40	45
Med To course SAND	45	50
COURSE SAND little P-gravel	50	65
med SAND	65	70
med + course SAND	70	80
COURSE SAND + P-gravel	80	120

If more than one screen, show location of each on sketch

Sketch the property layout and include the following: 1) the well location; 2) any permanent structures on the property that may aid in locating the well; 3) any roads, power lines, or other items that may aid in locating the property and the well; 4) indicate direction.

**RECEIVED**  
**APR 29 2005**  
**BY: OLWR**

Belzoni

From intersection Hwy #7 + old 49 north To Sky Lake Rd  
 3.1 Tent miles. Turn EAST ON Sky Lake Rd  $\frac{4}{10}$  of A  
 mile well located on north side of Road

Landowner Name: Rod Rodgers

Robert Byars  
 Signature of Water Well Contractor

# STATE WELL REPORT

## Part 2

**Pump Installer's Completion Report**  
 Mississippi Department of Environmental Quality  
 Office of Land and Water Resources  
 P.O. Box 10631  
 Jackson, MS 39289-0631  
 (601)961-5210  
 (601)354-6938 (fax)

**For Office Use Only:**

Aquifer: \_\_\_\_\_

Well #: C-158

Elevation: \_\_\_\_\_

County: Humphreys  
 Permit #: GW40160  
 Driller: mat nickles  
 Date completed: 4-25-05

This report should be prepared by the pump installer in detail and filed with the Department within 30 days of the installation of pump.

Well Owner Information	Well Location
Owner Name: <u>Rod Rodgers</u>	Latitude: <u>33° 15' 05" N</u> Longitude: <u>090° 31' 07" W</u>
Mailing Address: <u>RR2 Box 30</u>	Method of Lat/Long (circle one): Conventional Survey, USGS quad, <u>Hand-held GPS</u> , Survey-grade GPS
<u>Belzoni</u> MS <u>39038</u>	_____ 1/4 _____ 1/4 Sec _____ Twn _____ Rng _____
City State Zip Code	Distance Direction Nearest Town
Telephone No. <u>(662) 247-3778</u>	_____ Miles _____ of <u>Belzoni, MS.</u>

Pump Type Circle one	Power Type Circle one
Air Lift Jet Submersible	<u>Diesel Engine</u> Gasoline Engine Natural Gas
Bucket Piston <u>Turbine</u>	Electric Motor Hand Tractor PTO
Centrifugal Rotary Flowing Well	Windmill Other (specify): _____
Other (specify): _____	Horse Power Rating of Motor: <u>N/A</u>
Date Pump Installed: <u>4-25-05</u>	Setting Depth: <u>60</u> feet
Rated Pump Capacity: <u>2,100</u> Gallons Per Minute	Number of Stages: <u>2</u>

Pump Test Data	Method of Measuring Water Level Circle one
Date Well Tested: _____	Air Line Electric Measuring Line Steel Tape
Static Water Level (A): _____ Feet Below Land Surface	Other (specify): _____
Pumping Water Level (B): _____ Feet Below Land Surface	For flowing well, measured shut in head: _____ feet
Drawdown [(B) - (A)]: _____ Feet Below Land Surface	Well yielded _____ GPM with a drawdown of _____ feet after _____ hours of pumping
Test Pumping Rate: _____ Gallons Per Minute	
Duration of Pump Test (minimum 4 hours): _____ hours	

I HEREBY CERTIFY that the above statements are true to the best of my knowledge.

Robert Byars 0-543 Robert Byars  
 Print Name of Pump Installer and License No. (if applicable) Signature of Pump Installer

RECEIVED  
 APR 29 2005  
 BY: OLWR