

Final 5-11-09

#1

Part 2 never received 3/13

County: Humphreys
 Permit #: CW43203
 Driller: Charles M. Nichols
 Date drilling completed: 4-15-09

State Well Report
Part 1 - Driller's Log

Mississippi Department of Environmental Quality
 Office of Land and Water Resources
 P.O. Box 10631
 Jackson, MS 39289-0631
 (601)961-5210
 (601)354-6938 (fax)

For Office Use Only:
 Aquifer: _____
 Well #: C-125
 L. S. Elevation: _____
 E-log #: _____

State Law requires that this report be prepared by the license holder responsible for the work and filed with the Department at the above address within 30 days of completion of drilling of the well or borehole.

<p>Information on Well Owner (Landowner if borehole is not for a water well)</p> <p>Owner Name: <u>Rocky Bond</u> Mailing Address: <u>P.O. Box 66</u> <u>Midnight Ms. 39115</u> City State Zip Code Telephone No. <u>(662) 247-3939</u></p>	<p>Well or Borehole Location</p> <p>Latitude: <u>33° 11.130N</u> Longitude: <u>090° 23.690W</u> <u>08 41</u> Method of Lat/Long (circle one): Conventional Survey, USGS quad <u>Hand-held GPS</u> Survey-grade GPS <u>5N 5E 1/4 Sec 35</u> Twp <u>16N</u> Rng <u>3W</u> Distance Direction Nearest Town <u>0</u> Miles <u>0</u> of <u>Belzoni</u></p>
--	---

Well / Borehole Data

Date drilling started: 4-15-09 Date drilling completed: 4-15-09 Hole depth: 104 Hole diameter: 20

Location of the source of any surface water used for drilling: Fish Pond
 Method of dosing and volume of Chlorine used in drilling and development: HTH

Logs run (circle all applicable): No log run Electric Gamma Ray Density Sonic Neutron Other: _____
 Name of organization running log(s): _____

Purpose of borehole (check one): Water Well Geotechnical/Geological Investigation _____ Ground Source Heat Pump _____
 Seismic Survey _____ Other (describe) _____
If drilling is not related to water well construction, skip the remainder of this block

Purpose of Well (check one): Home _____ Industrial _____ Public Supply _____ Irrigation Fish Culture _____ Other: _____

If a flowing well, method of flow regulation: Valve _____ Other (describe) _____

Static Water Level: 25.5 feet above or below (circle one) land surface Date measured: 4-28-09
 Method of Measurement (circle one) steel tape electric tape air line other: _____

Well depth: 104 Well grouted to a depth of 10 feet Type of grout (circle one): Neat Cement Bentonite Mix

Casing length: 64 feet Casing diameter: 10 inches Type of casing: pvc
 Screen length: 40 feet Screen diameter: 10 inches Type of screen: pvc
 Screen slot size: 0.032 inches Setting depth: From 64 feet to 104 feet

Type of completion (circle all applicable): Gravel packed Underreamed Telescoped Open hole Natural Development
 Other (describe): _____

Top of lap pipe or reduction in casing: _____ feet. *If telescoped or more than one screen, describe on next page*

B+B Well Pump + PLUMBING

Form: OLWR-SWR-1A


RECEIVED

MAY 11 2009

BY: OLWR

The sketch below only required for water wells


If well telescopes, show depths on sketch

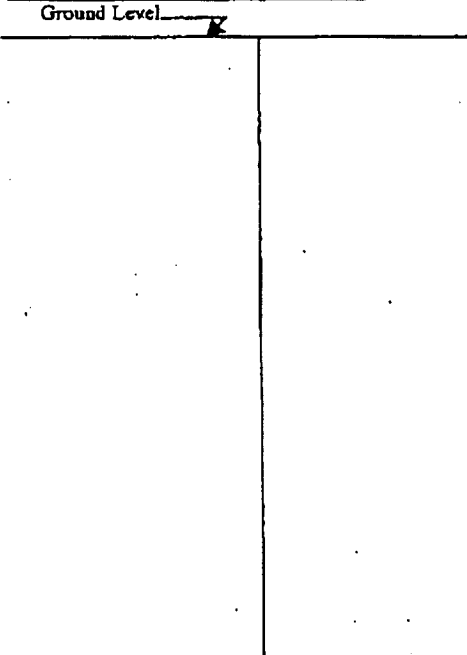

Description of formations encountered must be provided for all wells and boreholes, unless specifically exempted by regulations

Description of Formations Encountered	From (depth)	To (depth)
clay	Ground Level	43
fine sand	43	60
coarse sand & gravel	60	102
cemented gravel	102	104
fine sand	104	105

If more than one screen, show location of each on sketch

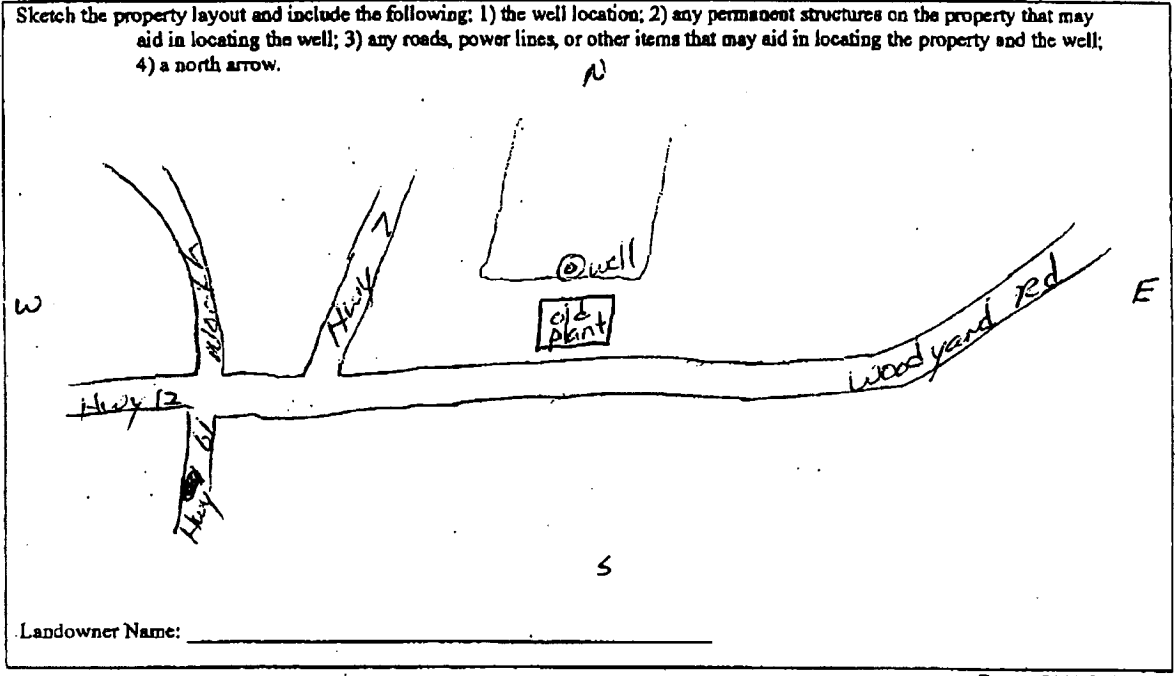

Form: OLWR-SWR-1A

I certify that the well/borehole was drilled, constructed, and completed in accordance with all applicable requirements of the Mississippi Department of Environmental Quality and the Mississippi Department of Health regulations, if applicable, and state laws.

Charles M. Nichols 0-067 5-6-09
 Print Name of Responsible Licensee and License No. Date

Charles M. Nichols
 Signature of Licensee

RECEIVED

MAY 11 2009

BY: OLWE