

County: Humphreys
 Permit #: GW43350
 Irrigation Equipment
 Driller: _____
 Date drilling completed: 6-25-09

State Well Report

Part 1

Mississippi Department of Environmental Quality
 Office of Land and Water Resources
 P.O. Box 10631
 Jackson, MS 39289-0631
 (601)961-5210
 (601)354-6938 (fax)

For Office Use Only:
 Aquifer: _____
 Well #: C177
 L. S. Elevation: _____
 E-log #: _____

State Law requires that this report be prepared by the driller in detail and filed with the Department within 30 days of completion of drilling of the well.

Well Owner Information	Well Location
Owner Name: <u>Triple R Farms</u>	Latitude: <u>33° 14' 31"</u> Longitude: <u>90° 33' 03"</u>
Mailing Address: <u>40 Rod Rodgers</u>	Method of Lat/Long (circle one): <u>Conventional Survey</u> , <u>USGS quad, Hand-held GPS, Survey-grade GPS</u>
<u>308 Dearenlente Road</u>	<u>SE 1/4 SW 1/4 Sec 7</u> Twn <u>16N</u> Rng <u>3W</u>
<u>Belzoni Ms. 39038</u>	Distance: <u>5</u> Miles Direction: <u>NW</u> of Nearest Town: <u>Belzoni</u>
City State Zip Code	
Telephone No. () _____	

Well Data

Purpose of Well (circle one) Home Industrial Public Supply Irrigation Fish Culture Other: _____

Date well drilling started: 6-25-09 Date well drilling completed: 6-25-09

If flowing, method of flow regulation: Valve _____ Other (describe) _____

Static Water Level: 30 feet above of below (circle one) land surface Date measured: 6-29-09

Method of Measurement (circle one) steel tape electric tape air line other: _____

Hole depth: 121 Well depth: 121 Well grouted to a depth of 10 feet

Type of grout (circle one): Cement Bentonite Mix

Casing length: 81⁷⁹ feet Casing diameter: 16 inches Type of casing: PVC

Screen length: 40 feet Screen diameter: 16 inches Type of screen: PVC

Screen slot size: .050 inches Setting depth: From 80 feet to 119 feet

Type of completion (circle all applicable): Gravel packed Underreamed Telescoped Open hole Natural Development
 Other (describe): _____

Top of lap pipe or reduction in casing: _____ feet. If telescoped or more than one screen, describe on back of page


Logs run (circle all applicable) No log run Electric Gamma Ray Density Sonic Neutron Other: _____

Name of organization running log(s): _____

I certify that the well was drilled, constructed, and completed in accordance with all applicable requirements of the Mississippi Department of Environmental Quality and/or the Mississippi Department of Health regulations and state laws.

Irrigation Equipment Inc.
 John P. Chism 0439

Print Name of Water Well Contractor and License No.

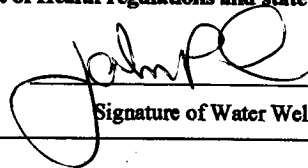
 Signature of Water Well Contractor

RECEIVED
 JUL 02 2009
 BY: OLWR

STATE WELL REPORT

Part 2

Pump Installer's Completion Report
 Mississippi Department of Environmental Quality
 Office of Land and Water Resources
 P.O. Box 10631
 Jackson, MS 39289-0631
 (601)961-5210
 (601)354-6938 (fax)

County: Humphreys
 Permit #: _____
 Irrigation Equipment
 Driller: _____
 Date completed: 6-25-09

For Office Use Only:

Aquifer: _____
 Well #: C177
 Elevation: _____

This report should be prepared by the pump installer in detail and filed with the Department within 30 days of the installation of pump.

Well Owner Information	Well Location
Owner Name: <u>Triple R Farms</u>	Latitude: <u>33°14'31"</u> Longitude: <u>90°33'03"</u>
Mailing Address: <u>C/O Rod Rodgers</u> <u>308 Deovenlente Rd.</u> <u>Belzoni Ms. 39038</u> City State Zip Code	Method of Lat/Long (circle one): Conventional Survey, USGS quad, Hand-held GPS, Survey-grade GPS <u>SE 1/4 SW 1/4 Sec 7 Twn 16N Rng 3W</u>
Telephone No. () _____	Distance Direction Nearest Town <u>5 Miles NW of Belzoni</u>

Pump Type Circle one	Power Type Circle one
Air Lift Jet Submersible	<u>Diesel Engine</u> Gasoline Engine Natural Gas
Bucket Piston <u>Turbine</u>	Electric Motor Hand Tractor PTO
Centrifugal Rotary Flowing Well	Windmill Other (specify): _____
Other (specify): _____	Horse Power Rating of Motor: <u>60</u>
Date Pump Installed: <u>6-29-09</u>	Setting Depth: <u>70</u> feet
Rated Pump Capacity: <u>2800 ±</u> Gallons Per Minute	Number of Stages: <u>1</u>

Pump Test Data	Method of Measuring Water Level Circle one
Date Well Tested: _____	Air Line Electric Measuring Line Steel Tape
Static Water Level (A): _____ Feet Below Land Surface	Other (specify): _____
Pumping Water Level (B): _____ Feet Below Land Surface	For flowing well, measured shut in head: _____ feet
Drawdown [(B) - (A)]: _____ Feet Below Land Surface	Well yielded _____ GPM with a drawdown of _____ feet after _____ hours of pumping
Test Pumping Rate: _____ Gallons Per Minute	
Duration of Pump Test (minimum 4 hours): _____ hours	

I HEREBY CERTIFY that the above statements are true to the best of my knowledge.

John P. Chism 0439
 Print Name of Pump Installer and License No. (if applicable)

John P. Chism
 Signature of Pump Installer

RECEIVED
 JUL 02 2009
 BY: OLWR

C177

R 3 W
SUNFLOWER COUNTY


Triple R Farms

R 5 W

SUNFLOWER COUNTY

R 4 W

T 17 N

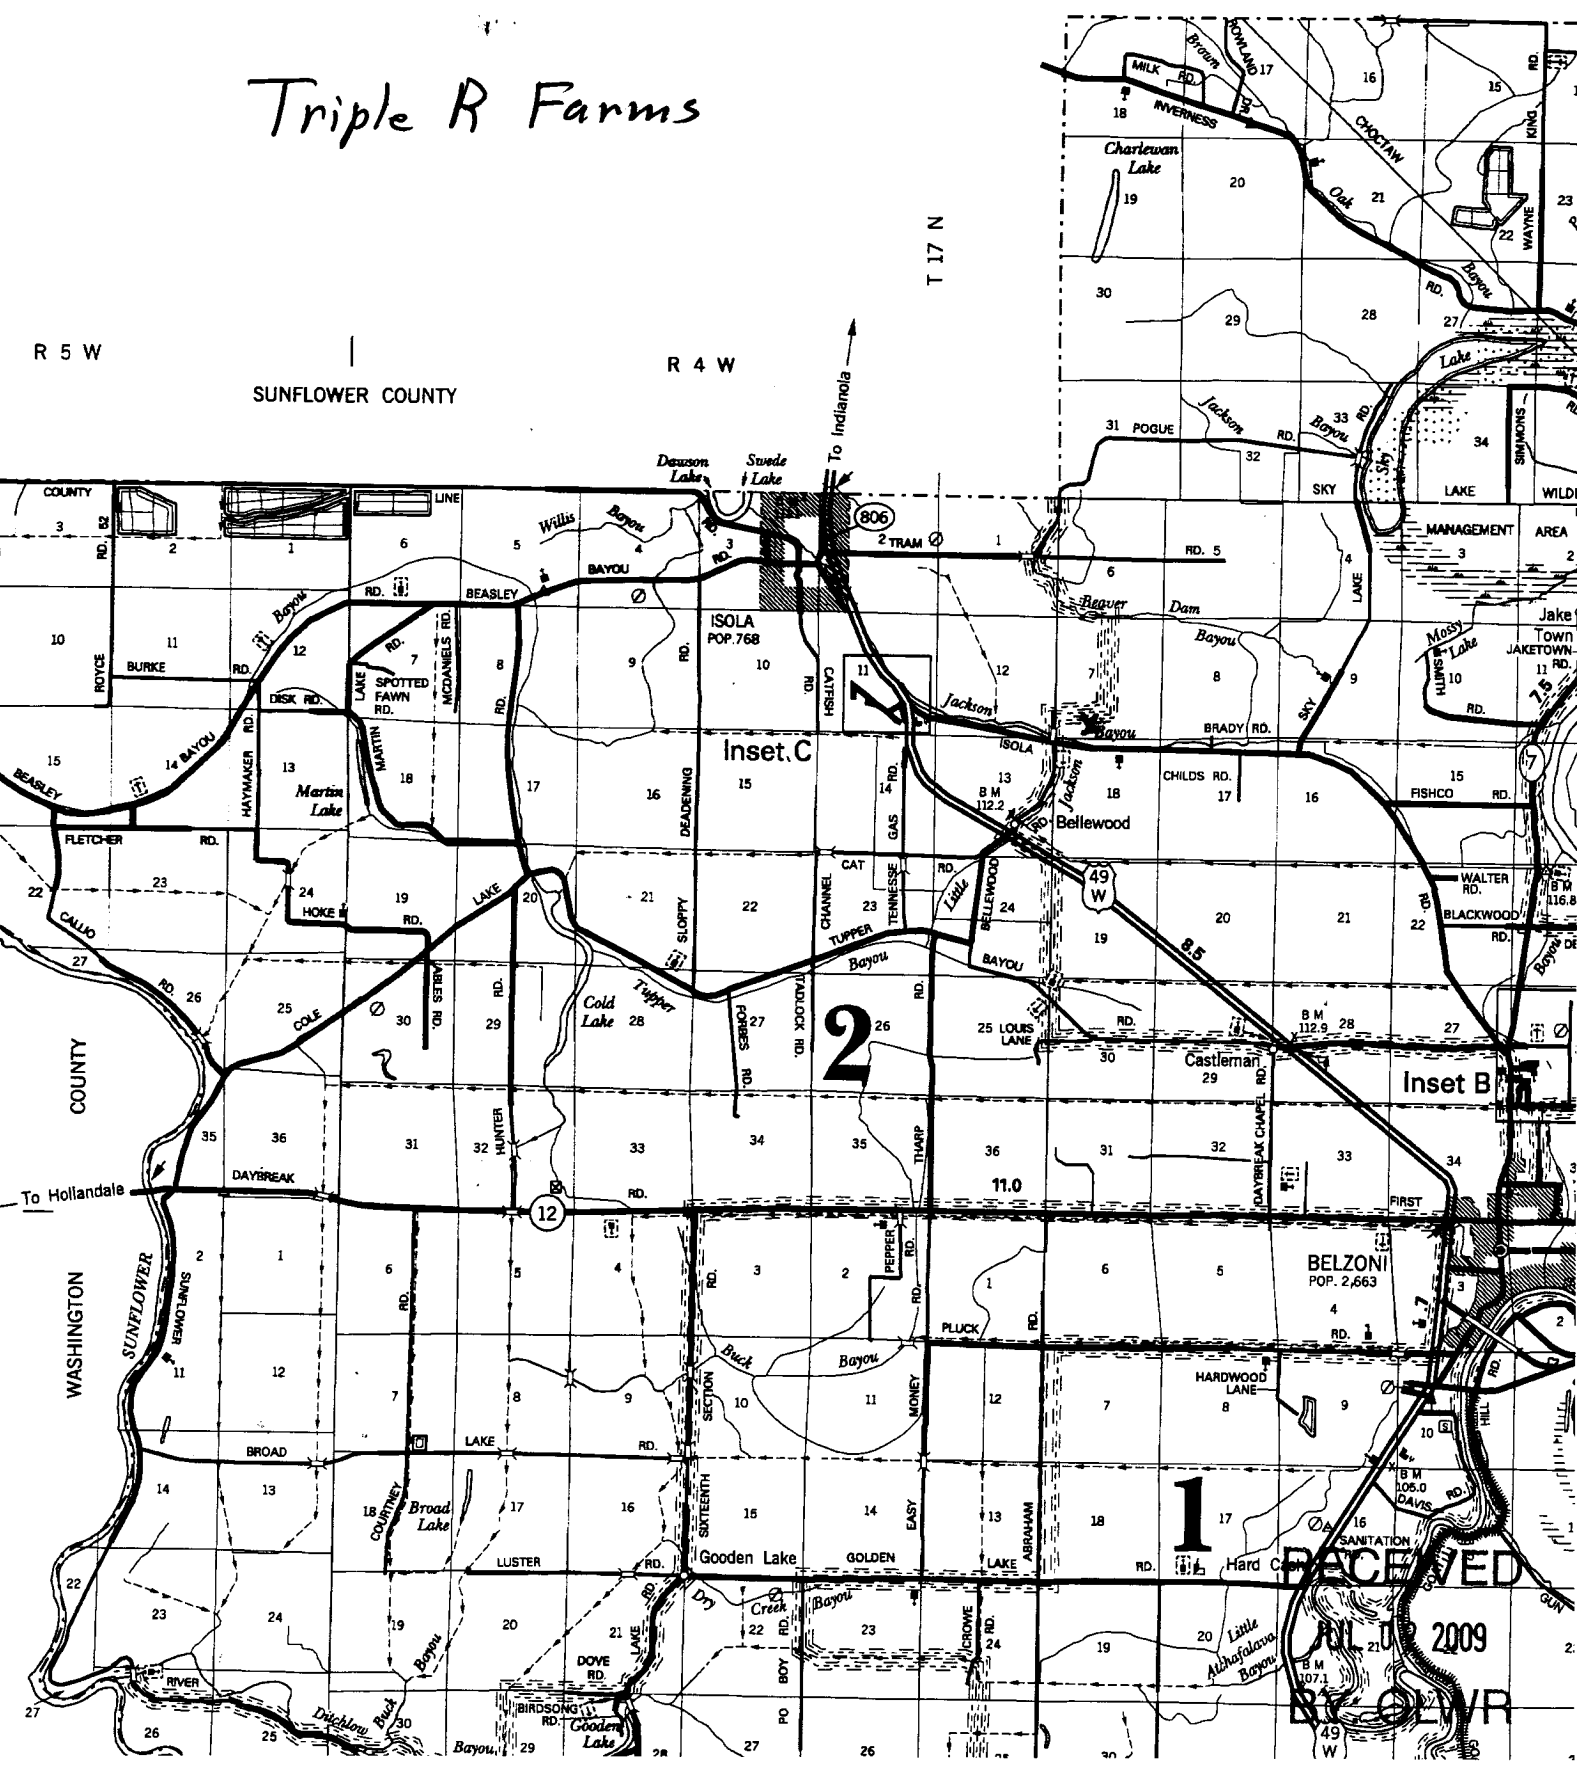

Inset C

Inset B

BELZONI
POP. 2,663

RECEIVED

OCT 20 2009

SUNFLOWER COUNTY BOARD OF SUPERVISORS