

County: Humphreys
 Permit #: GW-43170
 Driller: Irrigation Equipment
 Date drilling completed: 4/15/09

State Well Report
 Part 1

Mississippi Department of Environmental Quality
 Office of Land and Water Resources
 P.O. Box 10631
 Jackson, MS 39289-0631
 (601)961-5210
 (601)354-6938 (fax)

For Office Use Only:
 Aquifer: _____
 Well #: D-75
 L. S. Elevation: _____
 E-log #: _____

State Law requires that this report be prepared by the driller in detail and filed with the Department within 30 days of completion of drilling of the well.

Well Owner Information	Well Location
Owner Name: <u>Randomshot Farms</u>	Latitude: _____ Longitude: _____
Mailing Address: <u>29375 County Rd 526</u>	Method of Lat/Long (circle one): Conventional Survey, USGS quad, Hand-held GPS, Survey-grade GPS
<u>Minter City Ms. 38944</u> City State Zip Code	NW $\frac{1}{4}$ NE $\frac{1}{4}$ Sec <u>13</u> Twn <u>16N</u> Rng <u>2W</u> <u>SE</u>
Telephone No. () _____	Distance <u>8</u> Miles Direction <u>NE</u> of Nearest Town <u>Belzoni</u>

Well Data

Purpose of Well (circle one) Home Industrial Public Supply Irrigation Fish Culture Other: _____

Date well drilling started: 4/15/09 Date well drilling completed: 4/15/09

If flowing, method of flow regulation: Valve _____ Other (describe) _____

Static Water Level: 19 feet above of below (circle one) land surface Date measured: 4/16/09

Method of Measurement (circle one) steel tape electric tape air line other: _____

Hole depth: 120 Well depth: 120 Well grouted to a depth of 10 feet

Type of grout (circle one): Cement Bentonite Mix

Casing length: 80 feet Casing diameter: 16 inches Type of casing: PVC

Screen length: 40 feet Screen diameter: 16 inches Type of screen: PVC

Screen slot size: .050 inches Setting depth: From 81 feet to 120 feet

Type of completion (circle all applicable): Gravel packed Underreamed Telescoped Open hole Natural Development

Other (describe): _____

Top of lap pipe or reduction in casing: _____ feet. If telescoped or more than one screen, describe on back of page

Logs run (circle all applicable): No log run Electric Gamma Ray Density Sonic Neutron Other: _____

Name of organization running log(s): _____

I certify that the well was drilled, constructed, and completed in accordance with all applicable requirements of the Mississippi Department of Environmental Quality and/or the Mississippi Department of Health regulations and state laws.

Irrigation Equipment Inc.
 John P. Chism 0439

Print Name of Water Well Contractor and License No.

John P. Chism
 Signature of Water Well Contractor

RECEIVED
 APR 29 2009
 BY: OLWR

STATE WELL REPORT

Part 2

Pump Installer's Completion Report
 Mississippi Department of Environmental Quality
 Office of Land and Water Resources
 P.O. Box 10631
 Jackson, MS 39289-0631
 (601)961-5210
 (601)354-6938 (fax)

County: Humphreys
 Permit #: _____
 Irrigation Equipment
 Driller: _____
 Date completed: 4/15/09

For Office Use Only:

Aquifer: _____
 Well #: D-75
 Elevation: _____

This report should be prepared by the pump installer in detail and filed with the Department within 30 days of the installation of pump.


Well Owner Information	Well Location
Owner Name: <u>Randomshot Farms</u>	Latitude: _____ Longitude: _____
Mailing Address: <u>29375 County Rd 526</u>	Method of Lat/Long (circle one): <input type="checkbox"/> Conventional Survey,
<u>Minter City, Ms. 38944</u>	USGS quad, Hand-held GPS, Survey-grade GPS
City State Zip Code	<u>NW 1/4 NE 1/4 Sec 13 Twn 16N Rng 2W</u>
Telephone No. () _____	Distance Direction Nearest Town
	<u>8 Miles NE of Belzoni</u>

Pump Type Circle one	Power Type Circle one
Air Lift Jet Submersible	<input checked="" type="radio"/> Diesel Engine Gasoline Engine Natural Gas
Bucket Piston <input checked="" type="radio"/> Turbine	Electric Motor Hand Tractor PTO
Centrifugal Rotary Flowing Well	Windmill Other (specify): _____
Other (specify): _____	Horse Power Rating of Motor: <u>60</u>
Date Pump Installed: <u>4/16/09</u>	Setting Depth: <u>70</u> feet
Rated Pump Capacity: <u>2800[±]</u> Gallons Per Minute	Number of Stages: <u>1</u>


Pump Test Data	Method of Measuring Water Level Circle one
Date Well Tested: _____	Air Line Electric Measuring Line Steel Tape
Static Water Level (A): _____ Feet Below Land Surface	Other (specify): _____
Pumping Water Level (B): _____ Feet Below Land Surface	For flowing well, measured shut in head: _____ feet
Drawdown [(B) - (A)]: _____ Feet Below Land Surface	Well yielded _____ GPM with a drawdown of
Test Pumping Rate: _____ Gallons Per Minute	_____ feet after _____ hours of pumping
Duration of Pump Test (minimum 4 hours): _____ hours	

I HEREBY CERTIFY that the above statements are true to the best of my knowledge.

John P. Chism 0439
 Print Name of Pump Installer and License No. (if applicable)


 Signature of Pump Installer

RECEIVED
 APR 29 2009
 BY: OLWR

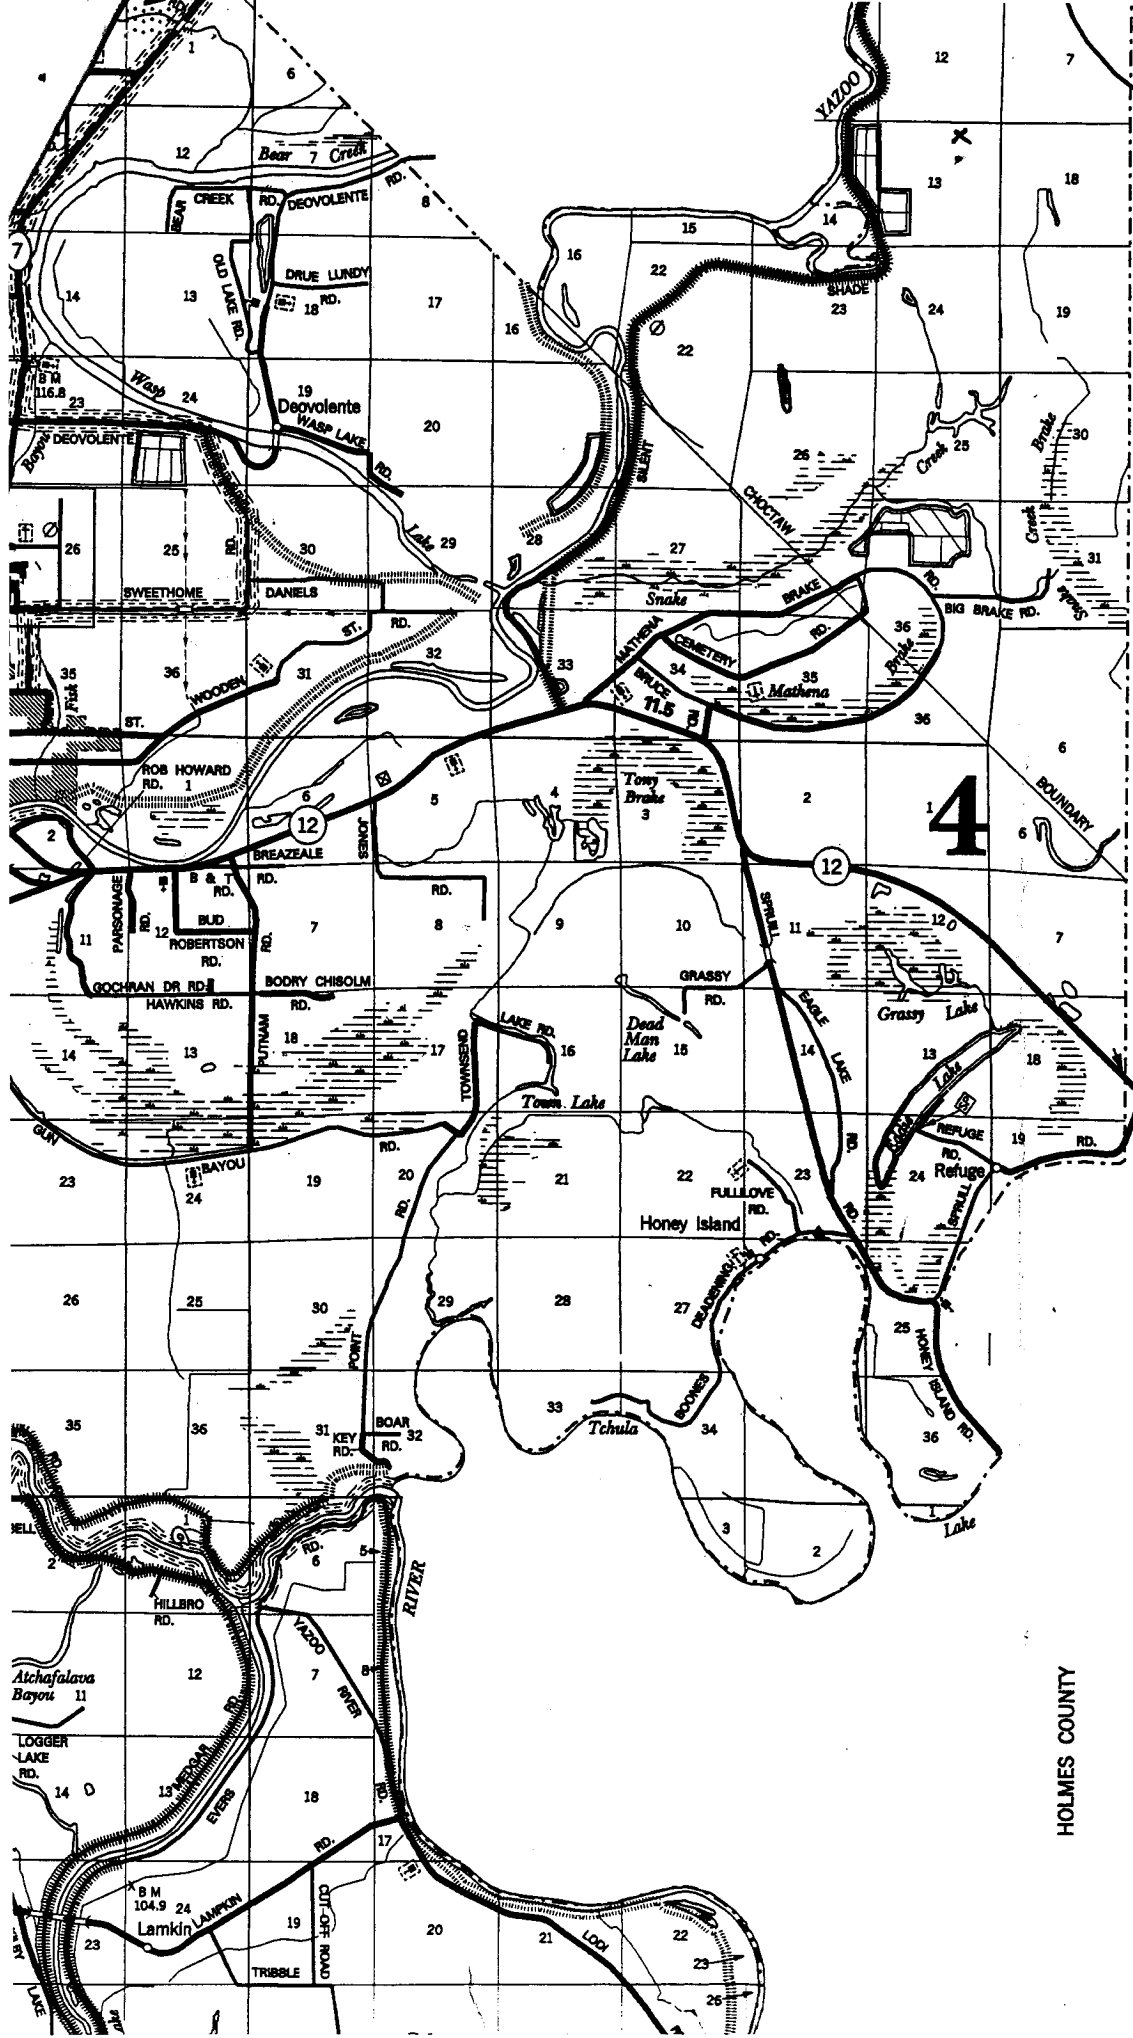

D-75

Randon Shot Farms

HOLMES COUNTY

T 16 N

T 15 N

T 14 N

HOLMES COUNTY

- INTERSTATE NUMBER -
- U.S. NUMBERED -
- STATE NUMBERED -
- RAILROAD STATION -
- GRADE CROSSING -
- RAILROAD ABOVE -
- RAILROAD BELOW -
- MILITARY AIRPORT -
- AIRPORT, LIMITED FA
- LANDING AREA OR :
- (INCLUDING PRI
- AIRPORT, COMPLETE
- AIRWAY LIGHT BEAC
- DRAINAGE A
- NARROW STREAM -
- DRAINAGE DITCH -
- LAKES AND RESERV
- OVERFLOW LAND -
- MARSH OR SWAMP
- STATE BOUNDARY -
- COUNTY BOUNDARY
- BEAT LINE -
- CONGRESSIONAL TO
- SECTION LINE -
- NATIONAL OR STATE
- RESERVATION, PARKS
- URBAN AREA COMP.
- INCORPORATED PLAI
- UNINCORPORATED D

With t
forth b
The me
Internal
in who
in a pr
You h
provide
Any enc
maps h
This a
Should
Post Of

RECEIVED
APR 29 2009
BY: OLWR