,	State We	II Report	The Cost of the Cost
1		rt 1	For Office Use Only:
County: Humphreys		of Environmental Quality	Aquifer: D80
Permit #: 6W-451931	Office of Land an	d Water Resources	Well #:
	P.O. Bo	x 10631	1
Driller: J. NEWCOME 0.773	Jackson, MS	39289-0631	L. S. Elevation:
Date drilling completed: 5-16-2011		61-5210	E-log #:
	(601)354	-6938 (fax)	E-log #:
State Law requires that this rep	ort be prepared by the	iriller in detail and filed v	with the Department within
30 days of completion of drilling	of the well.	We	Il Location
Well Owner Inform	ation	22 12 72	3." Longitude: 90.26,27."
Owner Name Dave Lundy	A		.
Mailing Address: 967 Mallo	in Drive	Method of Lat/Long (circle	
	•	USGS quad Hand-he	Twn 1/0V Rng 02W
Coppell I	75019 tate Zip Code		
Telephone No. ()	•	Distance Direction	Nearest Town of BELTONI
Тејернопе но.	Well	Data	
The state of the s			
Purpose of Well (circle one) Home I	ndustrial Public Supply	Irrigation Fish Culture	1
Date well drilling started: 5-16-	2011 Date	well drilling completed:	-16-2011
If flowing, method of flow regulation:	Valve Other	describe)	
Static Water Level:fee			
Method of Measurement (circle one)	steel tape electric tap	·	·
Hole depth: 103 Well	depth: 100	Well grouted to a depth	of 10 feet
Type of grout (circle one): Cement	Bentonite Mi	x	DIC
Casing length:feet (Casing diameter:	inches Type of casin	g. P.V.C. P.V.C
Screen length: 40 feet	Screen diameter:	inches Type of scree	n:
Screen slot size: .050 incl	nes Setting depth: From		100 feet
Type of completion (circle all application)	ble): Gravel packed Un	derreamed Telescoped (Open hole Natural Development
	Other (describe):		
Top of lap pipe or reduction in casing	,		e screen, describe on back of page
Logs run (circle all applicable). No l	og run Electric Gamma l	Ray Density Sonic Neutr	on Other:
Name of organization running log(s)		* */* TT TI	coble requirements of the Mississinni
I certify that the well was drilled, o	onstructed, and completed	in accordance with all appli	cable requirements of the Mississippi
	No and/on the Micciccioni	Department of Health regul	ations and state laws.

Print Name of Water Well Contractor and License No.

Signature of Water Well Contractor

AUG 0 8 2011

If well telescopes please sketch below and show depths.

Ground Level			Description of Formations Encountered	From	To
		A	JOP SOIL	10	10
		17	FINE SAND CLAY STEIRS	10	40
		11	MED. SAND	140	60
		11 / ~	COADJE SAND PER GRANT	100	100
		11 leaf	130TOM	1100	103
		10" casular			<u> </u>
	•				
	•				┼─
	. •	•			
		\	1		╂─
	•	A .>			
		10"scett			-
		10"scetter			
		1			<u> </u>
		 	<u> </u>		<u> </u>
					
					<u> </u>
		1			<u> </u>
		1	1	(1

If more than one screen, show location of each on sketch

Sketch the property layout and include the following: 1) the well location; 2) any permanent structures on the property that may aid in locating the well; 3) any roads, power lines, or other items that may aid in locating the property and the well; 4) indicate direction.
SEE MAD
Landowner Name:
Caldonic: Indic.

Signature of Water Well Contractor

County:	Hum	phre45
Permit #:	GW-	45193

Driller: J. NEWCOME 0-173 Date completed: 5.14.2011

STATE WELL REPORT

Part 2

Pump Installer's Completion Report Mississippi Department of Environmental Quality Office of Land and Water Resources P.O. Box 2309 Jackson, MS 39225 (601)961-5210

Aquifer: Well #:	
Well #: D	
	90
Elevation:	

(601)961-5228 (fax) Copy information from block on Part 1 This part of the report must be completed by a licensed water well contractor or a licensed pump installer. A copy of Part 1 of the report must be attached and both parts filed with the Department at the above address within 30 days of well completion. Well Owner Information Owner Name: Dave Lundy
Mailing Address: 967 Mallard Drive Latitude: 33013, 230 Longitude: 900 26, 27" Method of Lat/Long (check one): Conventional Survey USGS quad , Hand-held GPS , Survey-grade GPS GW 4 NE 4 Sec 19 TIGN R 02W stance Direction Rearest Town

Miles NE of Belloni Distance Telephone No. (Power Type Pump Type Circle one Circle one Diesel Engine Gasoline Engine Submersible Natural Gas Air Lift let Piston Turbine Electric Motor Hand Tractor PTO Bucket Other (specify): Flowing Well Windmill Centrifugal Rotary Horse Power Rating of Motor: Other (specify): Setting Depth: Date Pump Installed: Rated Pump Capacity: Number of Stages: Gallons Per Minute Method of Measuring Water Level **Pump Test Data** Circle one Date Well Tested: Air Line Electric Measuring Line Steel Tape Static Water Level (A): _____Feet Below Land Surface Other (specify): Pumping Water Level (B): _____Feet Below Land Surface Drawdown [(B) – (A)]: ______Feet Below Land Surface For flowing well, measured shut in head: Well yielded GPM with a drawdown of Gallons Per Minute Test Pumping Rate: feet after hours of pumping Duration of Pump Test (minimum 4 hours): New Well Replacement of Existing Pump Repair of Existing Pump


This is for (circle one):

I HEREBY CERTIFY that the above statements are true to the best of my knowledge

Print Name of Pump installer and License No. (if applicable)

Form: OLWR-SWF



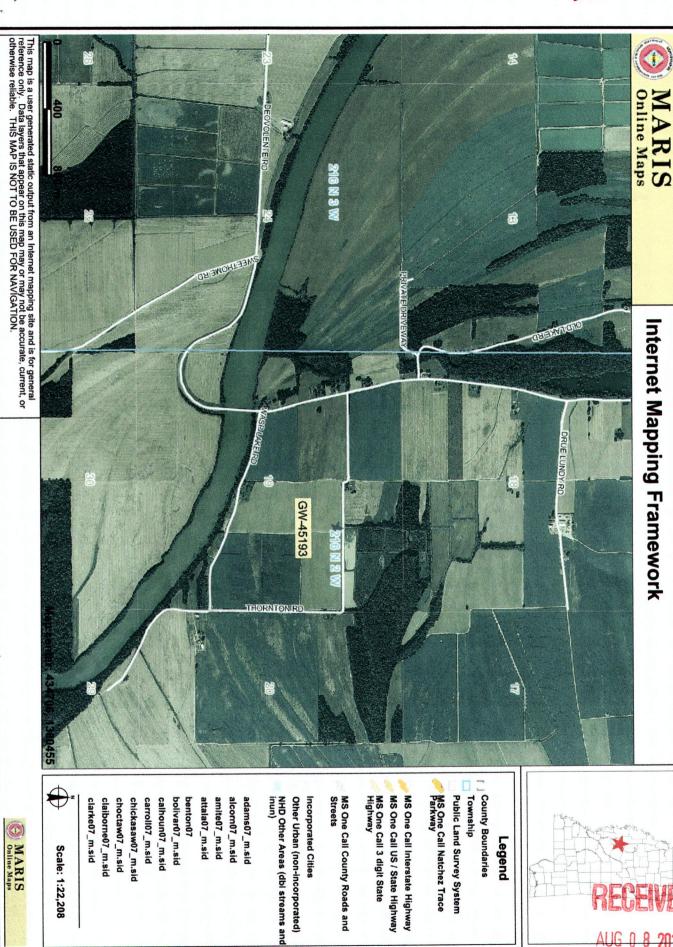

MARIS Online Maps

Scale: 1:22,208

Legend