

HUMPHREYS MISSISSIPPI BOARD OF WATER COMMISSIONERS

E 30

11-4-60

Date: 11-4, 1960, Driller: BITANE GAS CO OF CLAY COUNTY LE FLORIS

WATER WELL DRILLER

CODED

(Name)

| | | | |
|--|---|------------------------|---------------|
| (1) Owner of Land: <u>F. B. JANDYS</u> (Name) <u>BELZONI MISS</u> (Address) | Description & Color of Materials Sand, Clay, Red Clay, Shell, etc. | Thick- ness Feet | Depth Feet |
| (2) Location: <u>1/4, 1/4, Sec. 29 T15R9</u> <u>13</u> miles <u>SW</u> , of <u>BELZONI</u> (distance) (direction) (Nearest Town) | <u>TOPSOIL (CLAY)</u> | <u>28</u> | <u>28</u> |
| (3) Topography: <u>FLAT</u> (Hilly) (Flat) (Level) | <u>SILTY SAND</u> | <u>21</u> | <u>49</u> |
| (4) Purpose of Well: <u>IRRIGATION & RICE</u> (Domestic Irrigation Municipal, Industrial, Other) | <u>COARSE SAND</u> | <u>27</u> | <u>71</u> |
| | <u>PEA GRAVEL SAND</u> | <u>13</u> | <u>84</u> |
| | <u>PEA GRAVEL TALL</u> | <u>20</u> | <u>104</u> |

CODED


Information upon completion of well:

- (1) Diameter 16 inches.
- (2) Total Depth 104 feet.
- (3) Water Level 16 feet below top of ground.
- (4) Cased to 56, Size 16
- (5) Screen: Size 12", Length 48'
- (6) Were any formations sealed against pollution?
yes, X no.

YES depth of formation _____

Why _____

Drillers Remarks: _____

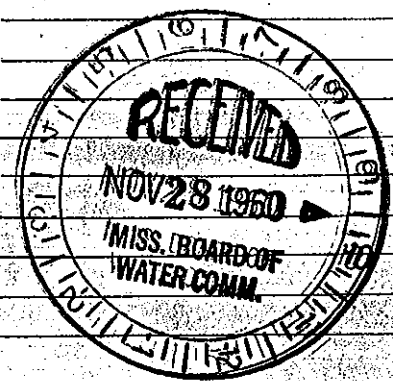

Well No.

(Use Back Side)

Mail this copy to Board of Water Commissioners 429 Miss. St. Jackson, Miss