

154

DYER WELL + IRR. SER. CODED

HUMPHREYS
E 34
8-13-68

MISSISSIPPI
 BOARD OF WATER COMMISSIONERS
 416 North State Street
 Jackson, Mississippi 39201

CODED

WATER WELL DRILLERS LOG

8-13 1968 date well completed
 McMillan firm name
 Humphreys county well located


LANDOWNER: W.R. McMillan
Belzoni, Miss.
 (mailing address)
 WELL LOCATION:
 sec. 13 T. 15 N R. 4 W
5 miles SW. of Belzoni
 (distance) (direction) (nearest town)

description of formations encountered	from	to
CLAY	0	12
SAND	12	75
SAND GRAVEL	75	248
ROCK	248	250
GRAVEL	250	265
SAND	265	382
BROWN SHALE	382	397
SAND	397	405
Gummy SHALE	405	468
SANDY SHALE	468	508
ROCK	508	509
SAND CLAY ST.	509	615
SHALE & SAND	615	668
SAND LARIE	668	688
SAND	688	706
Gummy SHALE	706	792
ROCK	792	794
SHALE ST.	794	941
SAND	941	992
CLAY	992	1000

WELL PURPOSE: HOME
 (home, irrigation, municipal, industrial)

WELL COMPLETION DATA:

- (1) diameter (inches) 4" x 2"
- (2) total depth (feet) 972'
- (3) static water level (feet) 6' below above top of ground.
- (4) casing 4" 972'
 (material) (depth)
- _____ if telescope see back.
 (size)
- (5) screen 20' 972'
 (length) (depth to top)
2" STAINLESS
 (size) (material)
- (6) pump 1 22
 (HP) (yield gpm)
ELEC.
 (type power)
- (7) electric log NO
 (yes or no)
- _____ (organization running log)
- (8) how well bottom plugged VALVE

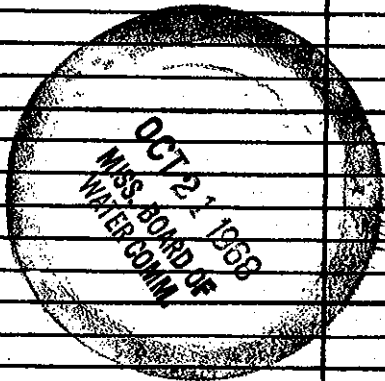

DRILLERS REMARKS: