

HUMPHREYS MISSISSIPPI BOARD OF WATER COMMISSIONERS

E 49
11-19-60

WATER WELL DRILLERS LOG

Date: Nov 19, 1960, Driller: Robert E. M. **CODED** Humphreys
(Name)

	Description & Color of Materials Sand, Clay, Red Clay, Shell, etc.	Thick- ness Feet	Depth Feet
(1) Owner of Land: Mr. Jeff Kiker (Name) Goodlake Miss (Address)	Gumbo Sand + Gravel	36	36
(2) Location: 1/4, 1/4, Sec. 21 T15R9	Shale Gumbo	20'	156
10 miles S/W of Belzoni, (distance) (direction) (Nearest Town)	Sand Shale Gumbo	120'	276
(3) Topography: Flat (Hilly) (Flat) (Level)	Sand s/w shale	167'	443
(4) Purpose of Well: Domestic (Domestic Irrigation Municipal, Industrial, Other)	Shale Gumbo sand	289'	732

Information upon completion of well:


- (1) Diameter 2 inches.
- (2) Total Depth 935 feet.
- (3) Water Level 8 feet below top of ground.
- (4) Cased to 925, Size 2"
- (5) Screen: Size 2", Length 20'
- (6) Were any formations sealed against pollution?
 yes, no.

If YES depth of formation 180'

Why Hard water

Drillers Remarks:

CODED

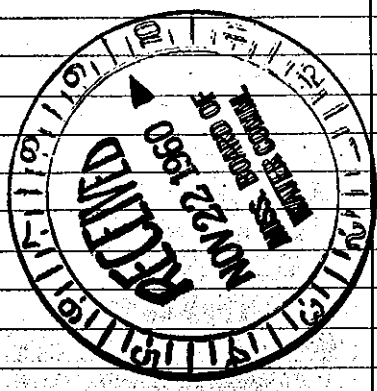

Well No.

(Use Back Side)