

HUMPHREYS  
E 101  
8-5-80

MISSISSIPPI DEPARTMENT OF NATURAL RESOURCES  
Bureau of Land and Water Resources  
Southport Mall  
P.O. Box 10631  
Jackson, Mississippi 39209  
WATER WELL DRILLERS LOG

CODED<sup>N</sup>

08/05 1980 Larry's Well & Pump Humphreys  
date well completed firm name county well located

LANDOWNER: John Whatley

description of formations encountered from to


Belzoni MS.  
(mailing address)

clay 35  
mud sand 70  
sand and gravel 70 121

WELL LOCATION:  
sec. 32 T. 15 N. R. 4 W.  
1 1/2 miles SW of BELZONI  
(distance) (direction) (nearest town)

WELL PURPOSE: Fish Pond  
(home, irrigation, municipal, industrial)

WELL COMPLETION DATA:

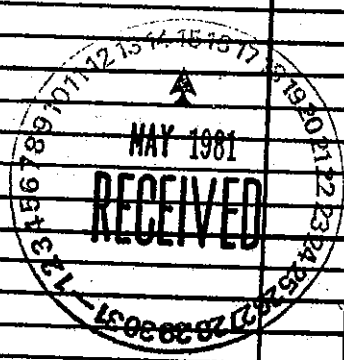

- (1) diameter (inches) 16"
- (2) total depth (feet) 121'
- (3) static water level (feet) 20 below top of ground
- (4) casing Steel 81'  
(material) (depth)

(size) If telescope see back.

- (5) screen 40' 81'  
(length) (depth to top)

1 1/2" Steel  
(size) (material)

- (6) pump 60 3000  
(HP) (yield gpm)

(type power)

- (7) electric log No  
(yes or no)

(organization running log)

- (8) how well bottom plugged Steel plate

DRILLERS REMARKS: