

Humphreys
E 105
10-2-80

MISSISSIPPI DEPARTMENT OF NATURAL RESOURCES
Bureau of Land and Water Resources
Southport Mall
P.O. Box 10631
Jackson, Mississippi 39209
WATER WELL DRILLERS LOG

CODED

10/02 1980 Larry's Well & Pump Humphreys
date well completed firm name county well located


LANDOWNER: Bob Price
Belzoni, MS.
(mailing address)

description of formations encountered	from	to
CLAY	0	30
FINE SAND + CLAY	30	60
COURSE SAND + GRAVEL	60	108

WELL LOCATION:
sec. 12-T-15-N R-4-E
5 miles W of Belzoni
(distance) (direction) (nearest town)

WELL PURPOSE: Fish Pond
(home, irrigation, municipal, industrial)

WELL COMPLETION DATA:
(1) diameter (inches) 16"
(2) total depth (feet) 108'
(3) static water level (feet) 2.3 below top of ground.
(4) casing Steel, 68'
(material) (depth)
(size) If telescope see back.
(5) screen 40' length, 68' depth to top
16" size, steel material
(6) pump 40 HP, 2000 yield gpm
(type power)
(7) electric log No (yes or no)
(organization running log)
(8) how well bottom plugged Steel Plate

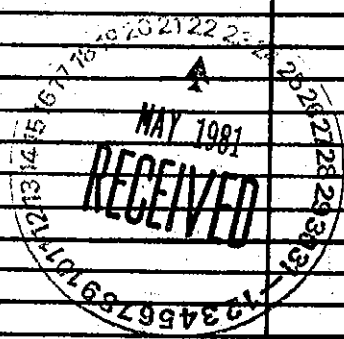

DRILLERS REMARKS: