

MISSISSIPPI DEPARTMENT OF NATURAL RESOURCES

Bureau of Land and Water Resources

Southport Mall

P.O. Box 10631

Jackson, Mississippi 39209

WATER WELL DRILLERS LOG

CODED

Humphrey
E 118
6-26-81
6/26/81

date well completed

firm name

county well located

Drewell & Ferguson Humphrey

LANDOWNER: Beel Coleman

description of formations encountered

from to

P.O. Box 641

Clay	0	38
Fine Sand	38	68
Sand & Gravel	68	110

Belzoni Ms 38930
(mailing address)

WELL LOCATION:

sec. 6 T. 15 N. R. 4 E
S W
6 1/2 miles W of DELZONI
(distance) (direction) (nearest town)


WELL PURPOSE:

(home, irrigation, municipal, industrial)

CODED

WELL COMPLETION DATA:

- (1) diameter (inches) 16
- (2) total depth (feet) 113
- (3) static water level (feet) 20 below above top of ground.
- (4) casing 40 Steel,
(material) (depth)
16
(size) If telescope see back.
- (5) screen 40'
(length) (depth to top)
16
(size) (material)
- (6) pump 40 200
(HP) (yield gpm)
Electric
(type power)
- (7) electric log NO
(yes or no)

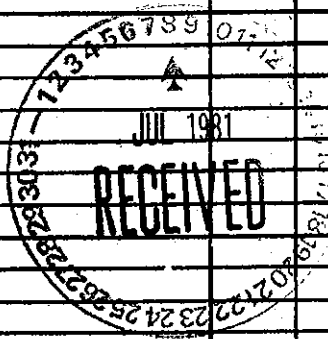

(organization running log)

(8) how well bottom plugged Plate

DRILLERS REMARKS: