

Humphreys
E17

MISSISSIPPI BOARD OF WATER COMMISSIONERS

CODED

331040
0903745

6-66
E133

WATER WELL DRILLERS LOG

Humphreys

Date: 6/20, 1966, Driller: Butane Gas Co., County: Iliore
(Name)

	Description & Color of Materials Sand, Clay, Red Clay, Shell, etc.	Thick- ness Feet	Depth Feet
(1) Owner of Land: <u>L. E. Grant</u> (Name) <u>Belzoni, Miss.</u> (Address)	Clay	13	13
	Sand & Gravel	10	23
(2) Location: <u>SW 1/4, NE 1/4, Sec. 5 T4 R12</u> <u>8</u> miles <u>W</u> of <u>Belzoni</u> (distance) (direction) (Nearest Town)	Blue Clay	10	33
	Sand & Gravel	10	43
	" "	10	53
	" "	10	63
	" "	10	73
(3) Topography: <input checked="" type="checkbox"/> (Flat) (Level)	" "	10	83
	" "	10	93
(4) Purpose of Well: <u>Irrigation</u> (Domestic Irrigation Municipal, Industrial, Other)	" "	10	103


Information upon completion of well:

- (1) Diameter 16 inches.
- (2) Total Depth 103 feet.
- (3) Water Level 20 feet below top of ground.
- (4) Cased to 63, Size 16.
- (5) Screen: Size 16, Length 40.
- (6) Were any formations sealed against pollution?
_____ yes, no.

If YES depth of formation _____

Why _____

Drillers Remarks: _____

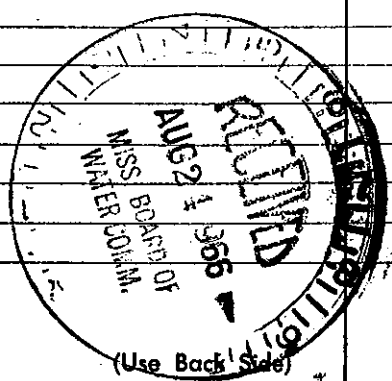

Well No.

Mail this copy to Board of Water Commissioners 429 Miss. St. Jackson, Miss.