

USE 1069

CODED

Humphreys
EDS 134
12-67

MISSISSIPPI
BOARD OF WATER COMMISSIONERS
416 North State Street
Jackson, Mississippi 39201
WATER WELL DRILLERS LOG

Dec. 11 19 67 Dyer Well & Irr. Ser. Humphreys
date well completed firm name county well located

LANDOWNER: G. B. Mortimer
R. R. Belzoni

Mississippi
(mailing address)

WELL LOCATION:
sec 15 T 15 N R 4 E
SW W
7 miles SW of Belzoni
(distance) (direction) (nearest town)

WELL PURPOSE: Irrigation
(home, irrigation, municipal, industrial)

WELL COMPLETION DATA:

(1) diameter (inches) 12"

(2) total depth (feet) 103'

(3) static water level (feet) 23' below above top of ground.

(4) casing Blk. Ir. 63'
(material) (depth)

(size) if telescope see back.

(5) screen 40' 63'
(length) (depth to top)

12" Blk. Iron
(size) (material)

(6) pump 33 1750
(HP) (yield gpm)


Butane
(type power)

(7) electric log No
(yes or no)

(organization running log)

(8) how well bottom plugged steel plate on bottom

description of formations encountered	from	to
Clay	0	13
Fine sand and clay	13	23
Blue Clay	23	32
Fine Sand	32	53
Fine sand and small gravel	53	63
Sand and large gravel	63	73
Sand and gravel shot with clay streaks	73	83
Sand and gravel	83	103

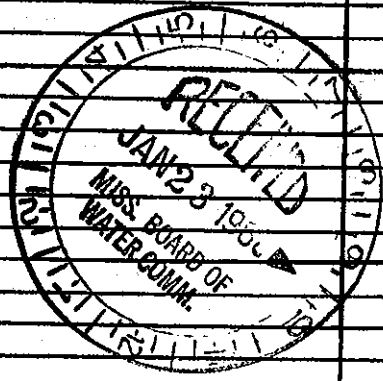

DRILLERS REMARKS: