

HUMPHREYS MISSISSIPPI BOARD OF WATER COMMISSIONERS

F 41

9-14-62

WATER WELL DRILLERS LOG **CODED**

Date: 9/14, 1962, Driller: R. Z. Minyard County Humphreys
(Name)

John A.

(1) Owner of Land: Bel McCarhey
(Name)
Belzoni, Miss.
(Address)

(2) Location: 1/4, 1/4, Sec. 8 T. 5 R. 3
2 miles South of Belzoni
(distance) (direction) (Nearest Town)

(3) Topography: ✓
(Hilly) (Flat) (Level)

(4) Purpose of Well: Domestic
(Domestic Irrigation Municipal)

Description & Color of Materials Sand, Clay, Red Clay, Shell, etc.	Thick- ness Feet	Depth Feet
Gumbo	0	20
Sand + clay	20	344
Clay + Gumbo + Sand	344	520
sand + shale	520	625
Shale + Gumbo	625	800
SAND + shale	800	850

Information upon completion of well:

(1) Diameter 2 inches.

(2) Total Depth 850 feet.

(3) Water Level 10 feet below top of ground.

(4) Cased to 850, Size 2"


(5) Screen: Size 2", Length 30'

(6) Were any formations sealed against pollution?
✓ yes, no.

If YES depth of formation _____
 Why seal off hard water

Drillers Remarks: _____

CODED

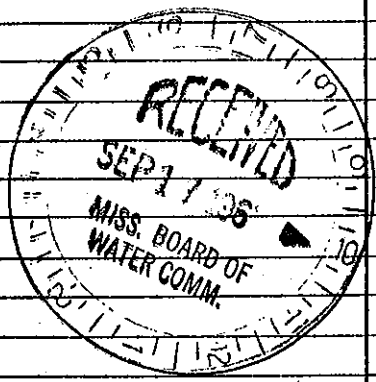

Well No.

(Use Back Side)

Mail this copy to Board of Water Commissioners 429 Miss. St. Jackson, Miss