

MISSISSIPPI BOARD OF WATER COMMISSIONERS

**CODED**

Humphreys  
OF 42  
4-06  
4-1

WATER WELL DRILLERS LOG

Humphreys

Date: 4-1, 19 66, Driller: Butane Gas Co. of Greenwood, Jeffere County


(Name)

(1) Owner of Land: <u>O. J. Turner, III</u> (Name) <u>Belzoni, Miss.</u> (Address)	Description & Color of Materials Sand, Clay, Red Clay, Shell, etc.	Thick- ness Feet	Depth Feet
	Top Soil	13	13
	Fine Sand	10	23
	Blue Clay	10	33
(2) Location: $\frac{1}{4}$ , $\frac{1}{4}$ , Sec. <u>19 T 15 R 3</u>	Blue Clay	10	43
<u>10</u> miles <u>West</u> of <u>Belzoni</u> (distance) (direction) (Nearest Town)	Sand and Gravel	10	53
(3) Topography: <u>Flat</u> (Hilly) (Flat) (Level)	Sand and Gravel	10	63
(4) Purpose of Well: <u>Irrigation</u> (Domestic Irrigation Municipal, Industrial, Other)	Sand and Gravel	10	73
	Sand and Gravel	10	83
	Sand and Gravel	10	93
	Sand and Gravel	10	103
	Sand and Gravel	10	113

Information upon completion of well:

- (1) Diameter 16 inches.
- (2) Total Depth 113 feet.
- (3) Water Level 21 feet below top of ground.
- (4) Cased to 73, Size 16
- (5) Screen: Size 16, Length 40
- (6) Were any formations sealed against pollution?  
\_\_\_\_\_ yes,  no.

**CODED**

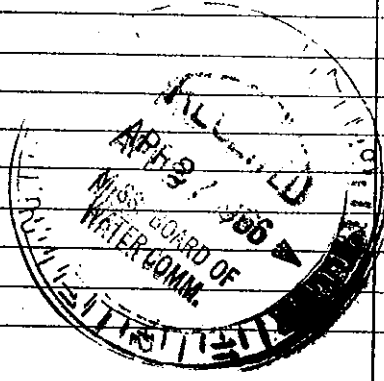

If YES depth of formation \_\_\_\_\_  
Why \_\_\_\_\_  
Drillers Remarks: \_\_\_\_\_  
\_\_\_\_\_  
\_\_\_\_\_

Retain this copy for your office files.

(Use Back Side)

Well No.