

Humphreys
F 75
10-10-80

MISSISSIPPI DEPARTMENT OF NATURAL RESOURCES
 Bureau of Land and Water Resources
 Southport Mall
 P.O. Box 10631
 Jackson, Mississippi 39209
WATER WELL DRILLERS LOG

CODED

date well completed 10/10 1980 Larney's Well & Pump firm name Humphreys county well located

LANDOWNER: Bob Harriston

Silver city
 (mailing address)

description of formations encountered	from	to
<u>CLAY</u>	<u>0</u>	<u>20</u>
<u>PIPE SAND</u>	<u>30</u>	<u>50</u>
<u>COURSE SAND GRAVEL</u>	<u>50</u>	<u>95</u>


WELL LOCATION:
 sec. 32 T. 15 N. R. 3 E
4 miles NW of Silver City
 (distance) (direction) (nearest town)

CODED

WELL PURPOSE: Fish Pond
 (home, irrigation, municipal, industrial)

WELL COMPLETION DATA:

- (1) diameter (inches) 16"
- (2) total depth (feet) 95'
- (3) static water level (feet) 21 below top of ground.
- (4) casing Steel, 55'
 (material), (depth)
 (size) If telescope see back.
- (5) screen 40', 55'
 (length), (depth to top)
16", Steel
 (size), (material)
- (6) pump 40 2000
 (HP), (yield gpm)
 (type power)
- (7) electric log No
 (yes or no)
 (organization running log)
- (8) how well bottom plugged Steel Plate

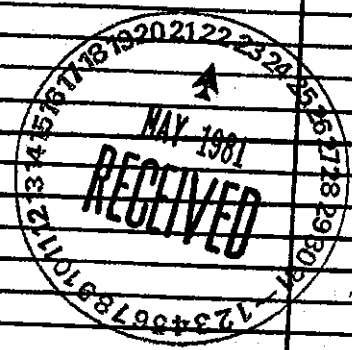

DRILLERS REMARKS: