

MISSISSIPPI DEPARTMENT OF NATURAL RESOURCES

Bureau of Land and Water Resources

Southport Mall

P.O. Box 10631

Jackson, Mississippi 39209

WATER WELL DRILLERS LOG **CODED**

Humphreys
 P 121
 6-26-81

date well completed 19 *6/26/81* firm name *Dyer well & Drng serv* county well located *Humphreys*

LANDOWNER: *S L Reed*

description of formations encountered	from	to
<i>6' clay</i>	<i>0</i>	<i>28</i>
<i>Sand & gravel</i>	<i>24</i>	<i>113</i>

Belzoni, Mo
 (mailing address)

WELL LOCATION:


sec *32* T *10* N R *3* E
6 miles *NE* of *Belzoni*
 (distance) (direction) (nearest town)

WELL PURPOSE:
 (home, irrigation, municipal, industrial)

CODED

WELL COMPLETION DATA:

- (1) diameter (inches) *16*
- (2) total depth (feet) *113*
- (3) static water level (feet) *20* below above top of ground.
- (4) casing *Steel* (material) (depth) *16* (size) if telescope see back.
- (5) screen *40* (length) (depth to top) *16* (size) (material)
- (6) pump *12* (HP) *2000* (yield gpm)
Electric (type power)
- (7) electric log *No* (yes or no)

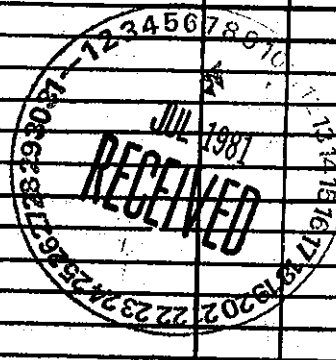

(organization running log)

(8) how well bottom plugged *Plate*

DRILLERS REMARKS: