

County: Humphreys
 Permit #: MS-GW-49508
 Driller: Tommy Reedock, Sr
 Date drilling completed: 5-31-16

STATE WELL REPORT

Part 1

Driller's Log

Mississippi Department of Environmental Quality
 Office of Land and Water Resources
 P.O. Box 2309
 Jackson, MS 39225-2309
 (601)961-5210
 (601)360-0535 (fax)

For Office Use Only:
 Well #: F 225
 Aquifer: _____
 E-Log #: _____

State Law requires that this report be prepared by the license holder responsible for the work and filed with the Department at the above address within 30 days of completion of drilling of the well or borehole.

<p>Well Owner Information (Landowner if borehole is not for a water well)</p> <p>Owner Name: <u>Peter Hairston</u></p> <p>Mailing Address: <u>P O Box 130</u></p> <p><u>Silver City</u> <u>MS</u> <u>39166</u> City State Zip Code</p> <p>Telephone No. () _____</p>	<p>Well or Borehole Location</p> <p>Latitude: <u>33° 06' 23</u> Longitude: <u>90° 31' 53</u></p> <p>Method of Lat/Long (check one): Conventional Survey _____, Hand-held GPS <input checked="" type="checkbox"/>, Survey-grade GPS _____</p> <p>USGS quad _____, <u>NE 1/4 NE 1/4</u> Sec. <u>32</u> T. <u>15N</u> R. <u>03W</u></p> <p><u>6</u> Miles <u>S</u> of <u>Belzer</u> (Distance) (Direction) (Nearest Town)</p>
--	--

Well / Borehole Data

Date drilling started: 5-31-16 Date drilling completed: 5-31-16 Hole depth: 115' Hole diameter: 24"

Location of the source of any surface water used for drilling: nearby pond

Method of dosing and volume of Chlorine used in drilling and development: when filling pit

Logs run (circle all applicable): No log run Electric Gamma Ray Density Sonic Neutron Other: _____

Name of organization running log(s): _____

Purpose of borehole (circle one): Water Well Geotechnical/Geological Investigation Ground Source Heat Pump Seismic Survey Other (describe) _____

If drilling is not related to water well construction, skip the remainder of this block

Purpose of Well (circle all applicable): Home Industrial Public Supply Irrigation Fish Culture

Other (describe): replacing - GW 09387

If a flowing well, method of flow regulation: Valve _____ Other (describe) _____

Static Water Level: 23 feet [above or below] land surface Date measured: 5-31-16
 (circle one)

Method of measurement (circle one): Steel tape Electric tape Air line Other (describe): _____

Well depth: 115' Well grouted to a depth of: 10 feet Type of grout (circle one): Neat Cement Bentonite Mix

Casing length: 75 feet Casing diameter: 16 inches Type of casing: PVC

Screen length: 40 feet Screen diameter: 16 inches Type of screen: PVC

Screen slot size: .032 inches Setting depth: From 75 feet to 115 feet

Type of completion (circle all applicable): Gravel packed Underreamed Open hole Natural Development

Other (describe): _____

Top of lap pipe or reduction in casing: _____ feet


If telescoped or more than one screen, describe on next page

Received

JUN 06 2016
 Form: OI WR-SWR-1A (2/7/13)

By OLWR

F 225

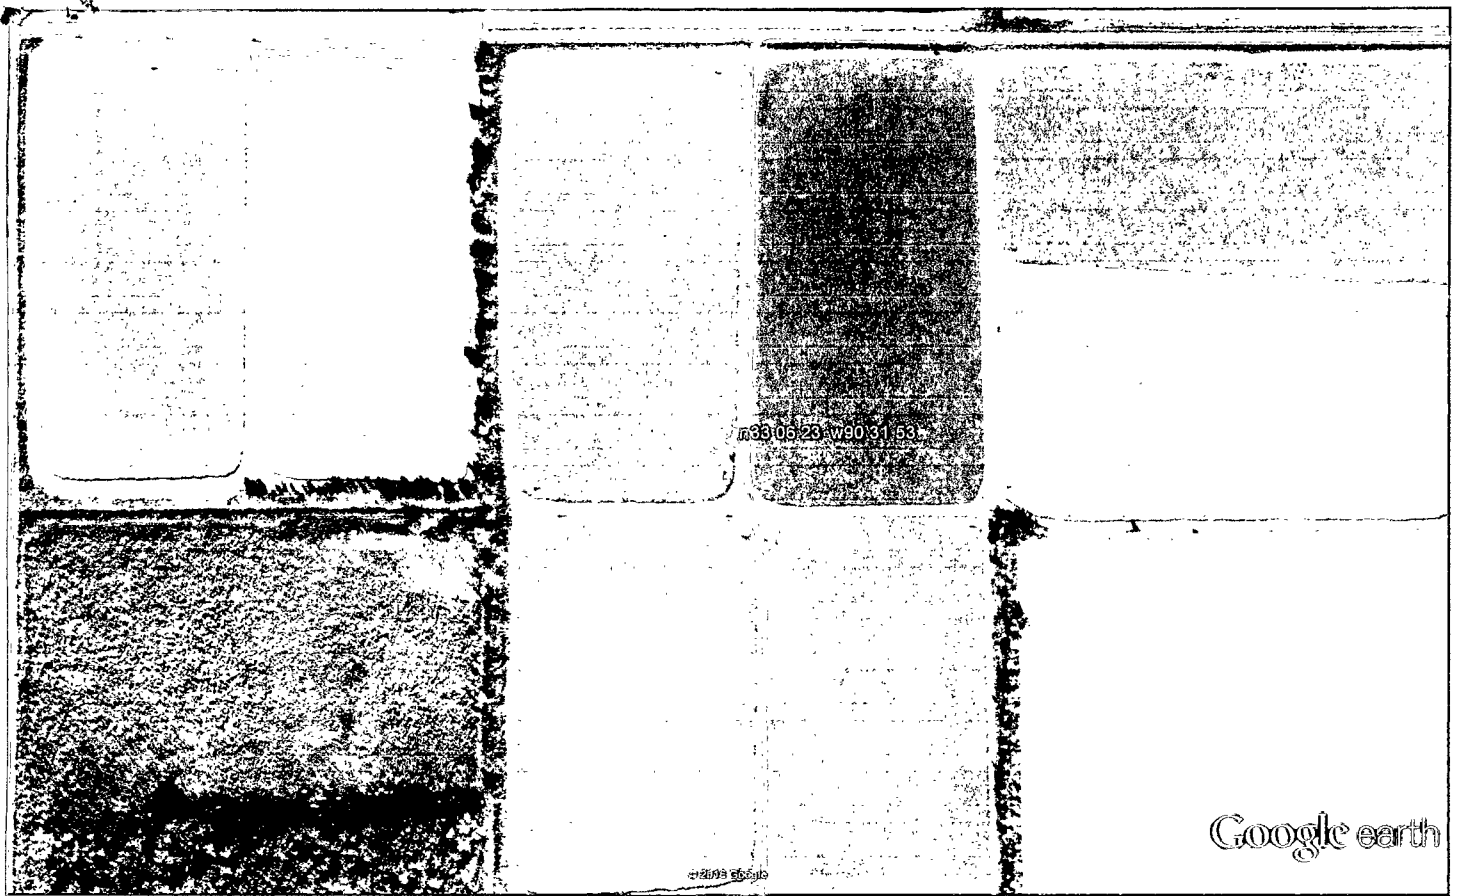

Google earth

feet
meters



Received

JUN 06 2016

By OLWR