

HUMPHREYS  
G 26  
8-8-80

MISSISSIPPI DEPARTMENT OF NATURAL RESOURCES

Bureau of Land and Water Resources

Southport Mall

P.O. Box 10631

Jackson, Mississippi 39209

WATER WELL DRILLERS LOG

**CODED**

08/08 1980 Larry's Well & Pump Humphreys  
 date well completed firm name county well located


LANDOWNER: Robert Edwards description of formations encountered from to  
Belzoni, MS (mailing address)  
 clay 0 20  
 fine sand 20 40  
 med sand 40 65  
 coarse sand 65 100

WELL LOCATION:  
 sec. 22 15 N R. 2  
9 miles SE of Belzoni  
 (distance) (direction) (nearest town)

WELL PURPOSE: Fish Pond  
 (home, irrigation, municipal, industrial)

WELL COMPLETION DATA:

- (1) diameter (inches) 16"
- (2) total depth (feet) 100'
- (3) static water level (feet) 16' below top of ground.
- (4) casing Steel 60'  
 (material) (depth)
- \_\_\_\_\_ If telescope see back.  
 (size)
- (5) screen 40' 60'  
 (length) (depth to top)
- 16" Steel  
 (size) (material)
- (6) pump \_\_\_\_\_  
 (HP) (yield gpm)
- \_\_\_\_\_ (type power)
- (7) electric log No  
 (yes or no)
- \_\_\_\_\_ (organization running log)
- (8) how well bottom plugged Steel Plate

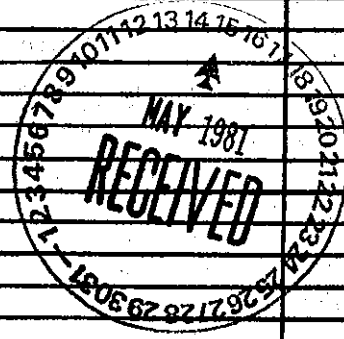

DRILLERS REMARKS: