

Humphreys
 531
 6-12-81
 Log # 61

MISSISSIPPI DEPARTMENT OF NATURAL RESOURCES
 Bureau of Land and Water Resources
 Southport Mall
 P.O. Box 10631
 Jackson, Mississippi 39209
WATER WELL DRILLERS LOG

COPIED

6/12-81 19 St. Gatz Explorations Humphreys
 date well completed firm name county well located

LANDOWNER: Robert Edwards
Belzoni Ms.


description of formations encountered	from	to
Sand & Gravel	0.0	174
Sand	174	320
Clay & Sand layers	320	585
Sand	585	710
Clay w/ sand	710	798
Sand	798	845
Clay w/ sand	845	1070

(mailing address)
 WELL LOCATION:
 sec. 26 T. 15 N R. 2 W
4 miles E of Belzoni
 (distance) (direction) (nearest town)

WELL PURPOSE: Hatchery
 (home, irrigation, municipal, industrial)

- WELL COMPLETION DATA:
- (1) diameter (inches) 6 1/4 / 5 1/2
 - (2) total depth (feet) 1070
 - (3) static water level (feet) _____ below above top of ground.
 - (4) casing Steel 810
 (material) (depth)
4 1/2 if telescope see back.
 (size)
 - (5) screen 3.0 810
 (length) (depth to top)
2" Stainless Steel
 (size) (material)
 - (6) pump Others
 (HP) (yield gpm)

 (type power)
 - (7) electric log yes
 (yes or no)
Ms Bureau of Geology
 (organization running log)
 - (8) how well bottom plugged Subsided

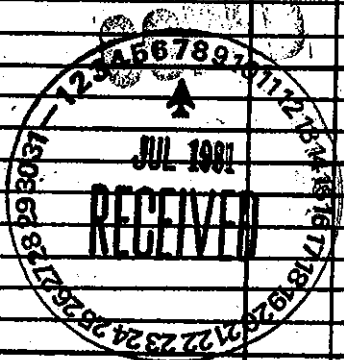

DRILLERS REMARKS: