
• •		
	State Well Report	For Office Use Only:
Humphreys Dary	Part 1	
Permit #: GW40082	Mississippi Department of Environmental Quality	-
IIIIgacion Equipment	Office of Land and Water Resources P.O. Box 10631	Well#: <u>6-70</u>
Driller:		L. S. Elevation:
Date drilling completed:	(601)961-5210	
÷	(601)354-6938 (fax)	E-log #:
State Law requires that this rej	, knc port be prepared by the driller in detail and filed	with the Department within
<u>30 days of completion of drillin</u>	g of the well.	ell Location
Well Owner Inform		
Dwner Name_ Po-Boy Land Co	Latitude: 33 06,0	5N, Longitude: 90, 23, 07W,
Mailing Address: 1250 Shadow	Wood Drive Method of Lat/Long (circle	one): Conventional Survey,
-		-
		eld GP9, Survey-grade GPS
Brandon, MS		<u>34</u> Twn 15N Rng 2W
City S		Nearest Town
Telephone No. $(- 354 - 4488)$	Distance Direction 7 Miles East	ofSilver_City
		······································
•	Well Data	
Purpose of Well (circle one) Home In	dustrial Public Supply Irrigation Fish Culture	Other:
Date well drilling started: 3-17	-05 Date well drilling completed:	3-17-05
	· •	
	alve Other (describe)	
Static Water Level:9' feet a	above or below (circle one) land surface Date measure	d: 3-31-05
	steel tape electric tape air line other:	
Iole depth: <u>116</u> Well d	epth:116' Well grouted to a depth o	ffeĕt
Type of grout (circle one): Cement	Bentonite Mix	
76		
		PVC Sch.40
Screen length:feet Sci	reen diameter: <u>16</u> inches Type of screen:	PVC Sch.40
0.5.0		
Screen slot size:050inches	Setting depth: From	feet
Type of completion (circle all applicable)): Gravel packed Underreamed Telescoped Op	en hole Natural Development
	Other (describe):	
Fop of lap pipe or reduction in casing:	feet. If telescoped or more than one s	screen, describe on back of page
Ors nun (circle all annlinable).	un Electric Gamma Ray Density Sonic Neutron	• •
	un Laconic Gamma Kay Density Somic Neutron	Uther:
Name of organization running log(s):		•
•	tructed, and completed in accordance with all applicab	
Department of Environmental Quality	and/or the Mississippi Department of Health regulation	ms and state laws.
Irrigation Equipmen	t Inc.	
Patrick M. Chism 06	95 Patrick	M Chini
Print Name of Water Well Contractor and	d License No.	of Water Well Contractor
	Signature	
		19 S. Rowen Sec. I during
		Que g
•		신원은 () 조가 : -
· · ·		


L

If well telescopes please sketch below and show depths.

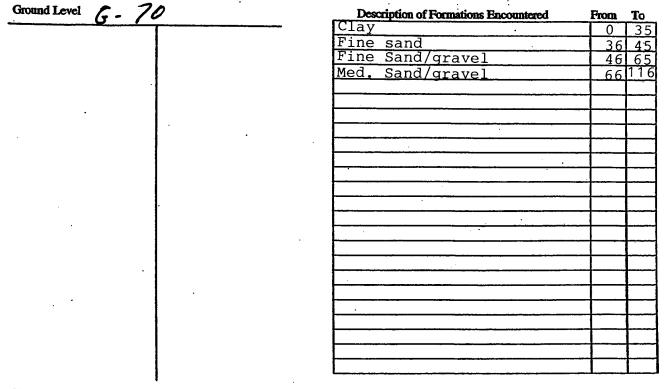

If more than one screen, show location of each on sketch

Sketch the property layout and include the following: 1) the well location; 2) any permanent structures on the property that may aid in locating the well; 3) any roads, power lines, or other items that may aid in locating the property and the well;
 4) indicate direction.

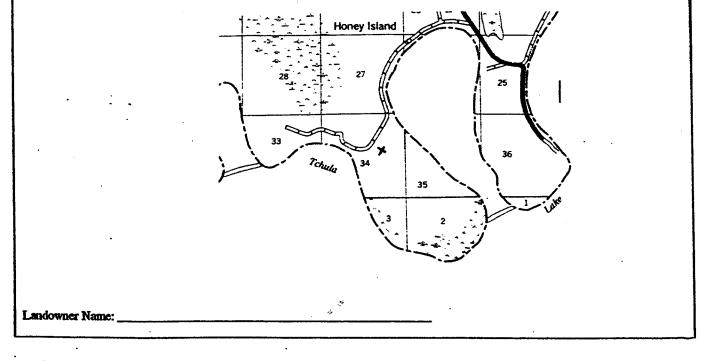

Signature of Water Well Contractor

.

i and Water Resources . Box 10631 MS 39289-0631 11)961-5210 354-6938 (fax) tail and filed with the Department within 30 days of the Well Location Latitude: Longitude: Method of Lat/Long (circle one): Conventional Survey, USGS quad, Hand-held GPS, Survey-grade (SW 14 NE Method of Lat/Long (circle one): Conventional Survey, USGS quad, Hand-held GPS, Survey-grade (SW 14 NE Method Distance Direction
tail and filed with the Department within 30 days of the Well Location Latitude:Longitude: Method of Lat/Long (circle one): Conventional Survey, USGS quad, Hand-held GPS, Survey-grade (
Latitude: Longitude: Method of Lat/Long (circle one): Conventional Survey, USGS quad, Hand-held GPS, Survey-grade (
Method of Lat/Long (circle one): Conventional Survey, USGS quad, Hand-held GPS, Survey-grade SW ₁₄ <u>NE</u> ¹ / ₄ Sec <u>34</u> Twn <u>15N</u> Rng <u>2</u> / ₄
Method of Lat/Long (circle one): Conventional Survey, USGS quad, Hand-held GPS, Survey-grade SW ₁₄ <u>NE</u> ¹ / ₄ Sec <u>34</u> Twn <u>15N</u> Rng <u>2</u> / ₄
USGS quad, Hand-held GPS, Survey-grade SW ₁₄ NE ¹ / ₄ Sec <u>34</u> Twn <u>15N</u> Rng <u>2</u> / ₄
<u>SW</u> ¹ / ₄ NE ¹ / ₄ Sec <u>34</u> Twn <u>15N</u> Rng <u>2</u> / ₄
Distance Direction Nearest Town
7 <u>Miles</u> East of Silver City
Power Type
Circle one
biesel Engine Gasoline Engine Natural
Electric Motor Hand Tractor
Windmill Other (specify):
Horse Power Rating of Motor: 80
Setting Depth:60feet
Number of Stages:3
Method of Measuring Water Level
Circle one
Air Line Electric Measuring Line Steel Ta
Other (specify):
For flowing well, measured shut in head:
Well yielded GPM with a drawdown of
feet afterhours of pur

RECEIVED APR 0 5 2005 BYOLWR