

HUMPHREYS
H 11

WATER WELL DRILLER **CODED** H 300

3-30-61

Date: 3-30, 1961, Driller: B. T. Dringard County Humphrey
(Name)

(1) Owner of Land: Ernest Robertson
(Name)

Midnight Miss.
(Address)

(2) Location: 1/4, 1/4, Sec. 13 17 4


1 miles North, of Midnight
(distance) (direction) (Nearest Town)

(3) Topography: flat
(Hilly) (Flat) (Level)

(4) Purpose of Well: domestic
(Domestic Irrigation
Municipal, Industrial, Other)

Description & Color of Materials Sand, Clay, Red Clay, Shell, etc.	Thick- ness Feet	Depth Feet
Sand and gravel	0	175
Sand 3/4 Shell	175	350
Shell and Shell gravel	350	550
Sand 3/4 Shell	550	620
Sand	620	650

CODED

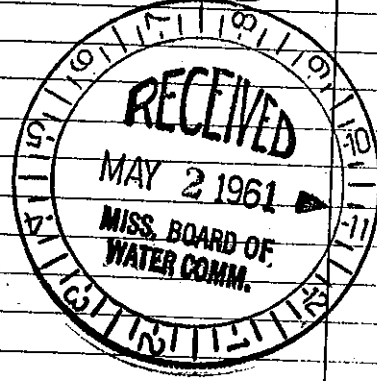

Information upon completion of well:

- (1) Diameter 2 inches.
- (2) Total Depth 650 feet.
- (3) Water Level 10 feet below top of ground.
- (4) Cased to 630 ft, Size 2"
- (5) Screen: Size 2", Length 20 ft.
- (6) Were any formations sealed against pollution?
 yes, no.

If YES depth of formation _____

Why All the way.

Drillers Remarks:

Retain this copy for your office files.

(Use Back Side)

Well No.