

HUMPHREYS MISSISSIPPI BOARD OF WATER COMMISSIONERS

H 14
9-63

WATER WELL DRILLERS LOG **CODED**

Date: Sept., 1963, Driller: David Benny County Yazoo
(Name)

(1) Owner of Land: Hugh Lane
(Name)
Midnight, Miss.
(Address)

(2) Location: 1/4, 1/4, Sec. 25 T. 14 R. 9
3 1/2 miles SE of Midnight
(distance) (direction) (Nearest Town)

(3) Topography: flat
(Hilly) (Flat) (Level)

(4) Purpose of Well: Domestic
(Domestic Irrigation, Municipal, Industrial, Other)

Description & Color of Materials Sand, Clay, Red Clay, Shell, etc.	Thick- ness Feet	Depth Feet
clay	20	20
clay	16	36
fine sand	4	40
sand	38	78
gravel	8	158
clay	100	240
clay	18	358
sand fine	2	260
sand good	39	299
sandy clay	1	300
clay with sand	20	320
shaly shale	20	340
sandy shale 6" mesh	20	360
sand	40	400
hard clay	40	440
broken sand (No log to 442)	40	480
fine sand	20	662
good sand	30	692

Information upon completion of well:

(1) Diameter 4 X 2 inches.

(2) Total Depth 692 feet.

(3) Water Level 8 feet below top of ground.

(4) Cased to 210, Size 4"


(5) Screen: Size 2", Length 30

(6) Were any formations sealed against pollution?
_____ yes, _____ no.

If YES depth of formation _____

Why _____

Drillers Remarks: _____

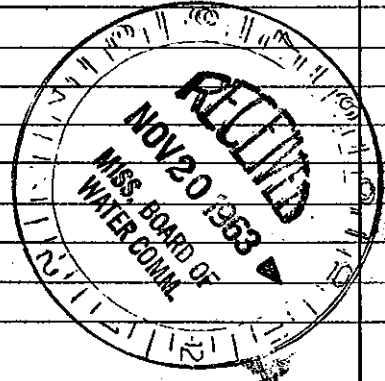

Well No.

(Use Back Side)

Mail this copy to Board of Water Commissioners 429 Miss. St. Jackson, Miss.