

HUMPHREYS  
H 38  
8-9-80

MISSISSIPPI DEPARTMENT OF NATURAL RESOURCES  
 Bureau of Land and Water Resources  
 Southport Mall  
 P.O. Box 10631  
 Jackson, Mississippi 39209  
**WATER WELL DRILLERS LOG**

**CODED**

Aug 09 1980 Larry's Well & Pump Humphreys  
 date well completed film name county well located


LANDOWNER: Brooks Aycock  
Ollie Mohamed  
A & M Fish  
Belzoni, MS.  
 (mailing address)

description of formations encountered	from	to
<u>clay</u>	<u>0</u>	<u>25</u>
<u>fine sand</u>	<u>25</u>	<u>45</u>
<u>coarse sand</u>	<u>45</u>	<u>65</u>
<u>coarse sand &amp; gravel</u>	<u>65</u>	<u>114</u>

WELL LOCATION:  
 sec. 6 T. 14 N R. 4 E  
14 miles SW of Belzoni  
 (distance) (direction) (nearest town)

WELL PURPOSE: Fish Pond  
 (home, irrigation, municipal, industrial)

WELL COMPLETION DATA:  
 (1) diameter (inches) 10"  
 (2) total depth (feet) 114'  
 (3) static water level (feet) 25' below top of ground.  
 (4) casing Steel 74'  
 (material) (depth)  
 (size) if telescope see back.  
 (5) screen 40' 74'  
 (length) (depth to top)  
10" Steel  
 (size) (material)  
 (6) pump 30  
 (HP) (yield gpm)  
 (type power)  
 (7) electric log No  
 (yes or no)  
 (organization running log)  
 (8) how well bottom plugged Steel  
Plate

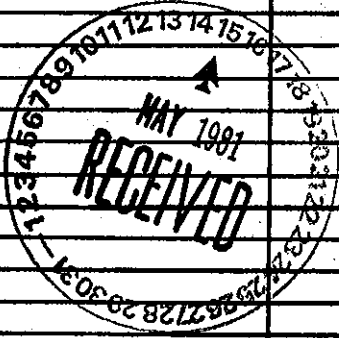

DRILLERS REMARKS: