

1517

CODED

CODED

CODED

HUMPHREYS
HA9
7-15-68

MISSISSIPPI
BOARD OF WATER COMMISSIONERS
416 North State Street
Jackson, Mississippi 39201

WATER WELL DRILLERS LOG

Jan 15 1968 Dyer Well Dr. Inc. Humphreys
date well completed firm name county well located


LANDOWNER:
W.S. MERCHANT JR.
LOUISE MISS
(mailing address)

WELL LOCATION:
sec. 20 T. 14 N. R. 4 W.
4 miles S.W. of MIDNITE
(distance) (direction) (nearest town)

WELL PURPOSE: FISH
(home, irrigation, municipal, industrial)

WELL COMPLETION DATA:
(1) diameter (inches) 12"
(2) total depth (feet) 103'
(3) static water level (feet) 18' below above top of ground.
(4) casing BUC. IR. 63'
(material) (depth)
12" If telescope see back.
(size)
(5) screen 40' 63'
(length) (depth to top)
12" BUC. IR.
(size) (material)
(6) pump 1 1/2 1200
(HP) (yield gpm)
BUTANE
(type power)
(7) electric log No
(yes or no)
(organization running log)
(8) how well bottom plugged PLATE

description of formations encountered	from	to
CLAY	0	13
CLAY + MED. SAND	13	23
COARSE SAND	23	33
FINE SAND	33	43
MED. SAND	43	53
COARSE SAND	53	63
C. SAND + GRAVEL	63	73
C. SAND + CLAY	73	83
C. SAND	83	93
	93	103

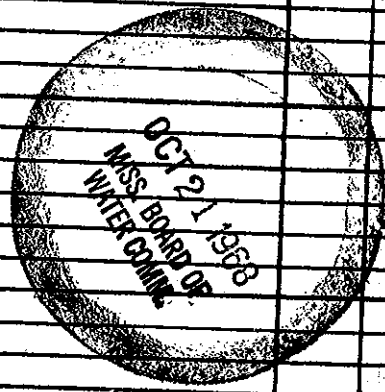

DRILLERS REMARKS: