

**MISSISSIPPI DEPARTMENT OF ENVIRONMENTAL QUALITY**

Office of Land and Water Resources

COUNTY WELL LOCATED <b>Humphreys</b>	
WELL NUMBER <b>H-74</b>	CODED
DATE WELL COMPLETED <b>4-7-01</b>	

PERMIT NUMBER
NAME OF DRILLING FIRM <b>Irrigation Equipment Inc.</b>
<b>Indianola, MS</b>

P. O. Box 10631  
Jackson, MS 39289-0631  
**WATER WELL DRILLERS LOG**

NAME & MAILING ADDRESS OF LANDOWNER <b>C.B. Box Company</b>			
<b>8159 Austin Peay Hwy. Rosemark, TN 38053</b>			
Latitude: Longitude:			
WELL LOCATION	SEC	TOWNSHIP	RANGE
<b>sw/ne</b>	<b>24</b>	<b>14N S</b>	<b>4W W</b>
DISTANCE	DIRECTION	NEAREST TOWN	
<b>Miles</b>	<b>East</b>	<b>of Midnight</b>	
OTHER LANDMARK			
WELL PURPOSE: Home, Irrigation, Municipal, Industrial, Fish Pond, etc. <b>Irrigation Pivot</b>			

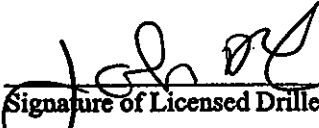
PUMP DATA		
PUMP TYPE (Circle One): Submersible, <b>Turbine</b> , Jet, Flowing Well, Other (Describe)		
POWER TYPE (Circle One): Electric, Tractor, <b>Diesel</b> , Gasoline, Butane, Other (Describe) <b>H/P 80</b>		
DESCRIPTION OF FORMATIONS ENCOUNTERED	FROM	TO
<b>Clay</b>	<b>0</b>	<b>15</b>
<b>Brown Sand</b>	<b>15</b>	<b>35</b>
<b>Fine Sand</b>	<b>35</b>	<b>55</b>
<b>Med. Sand</b>	<b>55</b>	<b>75</b>
<b>Coarse Sand</b>	<b>75</b>	<b>95</b>
<b>Coarse Sand/gravel</b>	<b>95</b>	<b>117</b>
Top of Lap Pipe or Reduction in Casing		
FEET <input type="checkbox"/> IF TELESCOPED OR MORE THAN ONE SCREEN: USE BACK PAGE		

WELL DATA		
Well Depth	Casing Diameter (in.)	Casing Length (ft.)
<b>117</b>	<b>16</b>	<b>77</b>
Type of Casing	Hole Depth	Depth to Static Water Level
<b>pvc</b>	<b>117</b>	<b>31ft.</b>
TYPE OF COMPLETION: (Circle One or More): <input checked="" type="checkbox"/> Gravel Packed, Underreamed, Telescoped, Natural Development, Open Hole, Other (Describe)		
WELL GROUTED TO A DEPTH OF _____ FEET Type Grout (circle one): Cement, Bentonite, or Mix		

SCREEN DATA		
Diameter - Inches	Length - Feet	Slot Size - Inches
<b>16</b>	<b>40</b>	<b>.050</b>
Screen Type	Depth to Bottom - Feet	
<b>pvc</b>	<b>117</b>	

**REC'D AUG 28 2001**

I certify that the well was drilled, constructed and completed in accordance with all applicable Requirements of the Mississippi Department of Environmental Quality and/or the Mississippi Department of Health regulations and state laws.


0-439
8-24-01  
 Signature of Licensed Driller and License No. Date

Additional Information Required On Back