

HUMPHREYS

J4

1-19-61

MISSISSIPPI BOARD OF WATER COMMISSIONERS

WATER WELL DRILLERS LOG

**CODED**

Date: 1-19, 1961, Driller: Robert T. Humphrey, Humphrey  
(Name)

(1) Owner of Land: Sandling Bros.  
(Name)

Silver City, Miss.  
(Address)

(2) Location: 1/4, 1/4, Sec. 20 T. 4 R. 3

4 miles Southeast of Silver City  
(distance) (direction) (Nearest Town)

(3) Topography:  (Level)

(4) Purpose of Well:  Domestic Irrigation  
(Municipal, Industrial, Other)

Description & Color of Materials Sand, Clay, Red Clay, Shell, etc.	Thick- ness Feet	Depth Feet
Sand and gravel		0
Shells, shell and sand		190
Sand & shell		211
Shell, gum and sandy shell		292
Shell, gum, rock and sand		498
Sand		747
Sand & shell		851
Shell, gum, bottom		955

Information upon completion of well:


- (1) Diameter 2 inches.
- (2) Total Depth 955 feet.
- (3) Water level 3 feet below top of ground.
- (4) Cased to 955, Size 2"
- (5) Screen: Size 2", Length 30'

**CODED**

(6) Were any formations sealed against pollution?  
 yes,  no.

If YES depth of formation All the way to bottom.

Drillers Remarks:

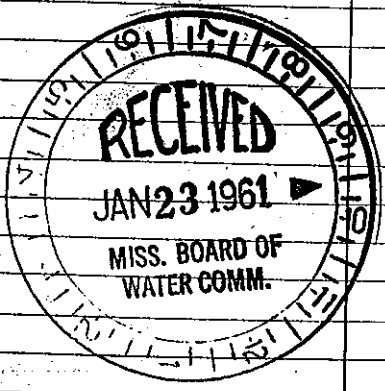

Well No.

(Use Back Side)

Mail this copy to Board of Water Commissioners 429 Miss. St. Jackson, Miss