

MISSISSIPPI DEPARTMENT OF NATURAL RESOURCES

Bureau of Land and Water Resources

Southport Mall

P.O. Box 10631

Jackson, Mississippi 39209

WATER WELL DRILLERS LOG

CODED

Humphreys  
 546  
 3-28-81


March 28 1981 date well completed  
 Larry's Well & Pump firm name  
 Humphreys county well located

LANDOWNER: <u>Larry Wise</u>	description of formations encountered	from	to
<u>Silver City, Mo.</u> (mailing address)			
	<u>COURSE SAND</u>	<u>60</u>	<u>108</u>

WELL LOCATION:  
 sec. 29 T 14 N R. 30 W  
4 miles E of Midway  
 (distance) (direction) (nearest town)

WELL PURPOSE:  
 (home, irrigation, municipal, industrial)

- WELL COMPLETION DATA:
- (1) diameter (inches) 8"
  - (2) total depth (feet) 102'
  - (3) static water level (feet) 18 below above top of ground.
  - (4) casing Plastic, 62'  
(material) (depth)  
 \_\_\_\_\_ If telescope see back.  
(size)
  - (5) screen 40', 62'  
(length) (depth to top)  
8", Plastic  
(size) (material)
  - (6) pump 7 1/2  
(HP) (yield gpm)  
 \_\_\_\_\_ (type power)
  - (7) electric log No  
(yes or no)  
 \_\_\_\_\_ (organization running log)
  - (8) how well bottom plugged PVC  
cap

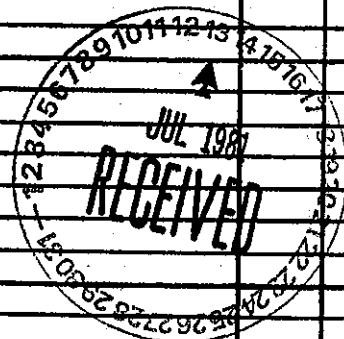

DRILLERS REMARKS: