County:	Humphreys	
Permit #:	GW-47259	/
Į.	Irrigation Eq	
Date drill	ing completed:	05/27/2013

Other (describe):

Top of lap pipe or reduction in casing:

## STATE WELL REPORT

## Part 1

Driller's Log

Mississippi Department of Environmental Quality Office of Land and Water Resources P.O. Box 2309

Jackson, MS 39225-2309 (601) 961-5210 (601) 360-0535 (fax)

For	Office Use Only:
Well#:	7 148
Aquifer:	
E-Log #:	

State Law requires that this report be prepared by the license holder responsible for the work and filed with the Department at the above address within 30 days of completion of drilling of the well or borehole. Well Owner Information Well or Borehole Location (Landowner if borehole is not for a water well) Owner Name: Seward & Harris Latitude: 33 02' 54.7 N Longitude: 90 33' 16.0 W Mailing Address: P.O. Box 249 Method of Lat/Long (check one): 

Conventional Survey. ☐ USGS quad, ☑ Hand-held GPS, ☐ Survey-grade GPS 1/4 NW 1/4, Sec 19 T 14 N R 3 W 39097 Louise Ms City State Zip code Telephone No. **East** Midnight Miles (Distance) (Direction) (Nearest Town) Well / Borehole Data Date drilling started: 05/27/2013 Date drilling completed: 05/27/2013 Hole depth: 125 Hole diameter: 24" Location of the source of any surface water used for drilling: Method of dosing and volume of Chlorine used in drilling and development: Logs run (check all applicable): ☑ No log run ☐ Electric ☐ Gamma Ray ☐ Density ☐ Sonic ☐ Neutron ☐ Other: Name of organization running log(s): Purpose of borehole (check one): Water Well Geotechnical/Geological Investigation Ground Source Heat Pump ☐ Seismic Survey Other (describe) If drilling is not related to water well construction, skip the remainder of this block Purpose of Well (check all applicable): ☐ Home ☐ Industrial ☐ Public Supply ☑ Irrigation ☐ Fish Culture ☐ Other (describe): If a flowing well, method of flow regulation: Valve Other (describe) Static Water Level: 24 feet [☐ above or ☒ below] land surface Date measured: 05/27/2013 (check one) Method of Measurement (check one) ☑ Steel tape ☐ Electric tape ☐ Air line ☐ Other: (describe) Well depth: 125 Well grouted to a depth of: 10 feet Type of grout (check one): ☐ Neat Cement ☑ Bentonite ☐ Mix Casing length: 85 feet Casing diameter: 16 inches Type of casing: PVC Screen length: 40 feet Screen diameter: 16 Type of screen: PVC inches Screen slot size: .050 inches Setting depth: From 86 feet to 125 feet Type of completion (check all applicable): 🛛 Gravel packed 🗌 Underreamed 🗍 Open hole 🗎 Natural Development

Feet

If telescoped or more than one screen, describe on next page

Form: OLWR-SWR-11/4/13] 7 2013

BY: OLWR

			For Office U	-
County: Humphreys			Vell#:	48
Permit #: <b>GW-47259</b>		L		
The sketch below only required	for water wells	Description of formations encoun		
f well telescopes, show depths	on sketch.	and boreholes, unless specifically	exempted by regulation	<u>s</u>
Ground level	•	Description of Formations Enco		
Sidding level		Clay Fine Sand & Gravel	Ground le	61 52
		Medium Sand & Gravel	62	125
f more than one screen, sho	w location of each on sketch			
1) the well location	t and include the following: ructures on the property that may	/ aid in locating the well		
		fin locating the property and the w	e <b>li</b>	
andowner Name: S	ines, or other items that may aic	in locating the property and the w	Form: OLV	· ·
andowner Name: S	ines, or other items that may aic	in locating the property and the w	Form: OLV	VR-SWR-1A (04/08 e alations,

RECEIVED

JUN 1 7 2013

County:	Humphreys	
Permit #:	GW-47259	
Driller:	Irrigation Eq	uipment
Date drill	ing completed:	05/27/2013
Сору	information from	n block on Part 1


## STATE WELL REPORT Part 2

Pump Installer's Completion Report
Mississippi Department of Environmental Quality
Office of Land and Water Resources
P.O. Box 2309
Jackson, MS 39225-2309
(601) 961-5210
(601) 360-0535 (fax)

For	Office Use Only:
Vell#:	J148
lquifer:	

of the report must be attac Well O	wner Information		er serveru uu ini	C GUUTE BUUT	Well Lo		жен сотриетоп.
Owner Name: Seward &	. Harris		Latitude:	33 02' 54.7	7 N L	ongitude:	90 33' 16.0 W
Mailing Address: P.O. B	ox 249						ventional Survey,
Training / Idahada.	35.2.0		_		,		••
			Usgs	quad, 🛛 Ha	and-held Gf	PS, 🗌 Sur	vey-grade GPS
Louise	Ms	39097		<u>SW % I</u>	<b>₩</b> ¼, Sec	<u>19</u> T <u>14 N</u>	1 R <u>3 W</u>
City Talanhana Na /	State	Zip code		B 474	Cont	-	A Status and A
Telephone No.	<u> </u>		1 (Distan	Miles	East (Direction)	of	Midnight (Nearest Town)
		Pirmn Tvr	e (check one	ol .			
☐ Submersible Ø Turbine	□ Air Lift □ Cont				-1		24 _ \.
☐ Submersible ☑ Turbine	(0710040						
Date Pump Installed <u>05</u> Is This Pump (check one):				Capacity: _4	COUT!-		Gallons Per Minute
s mar ump (check offe).	KN MEM IT MENSIL		u pe (check on:	e)			
☐ Electric ☑ Diesel ☐ Ga	soline 🔲 Natural C			•	scribe)		
Horse Power Rating of Mot					-	er of Stage	es: 1
		sopiii.		''		- G Glagi	
		Pump Test Data f	or Non Flow	ring Well			
Date Well Tested:			Duration o	f Pump Test	(minimum	4 hours):	Hour
Static Water Level (A):							
Orawdown [(B) - (A)]:							
Method of measurement (c							
		Pump Test Dat					
Measured shut in head:	Fe		a for a lower	g IICn			
Well yielded	GPM with a dra	ıwdown of		feet after _		hou	urs of pumping
		Meter I	nstallation				
Meter Manufacturer: No	ne Installed			Serial Numbe	er:		
Meter Model Number/Name	<b>a</b> :						REC
Totalizer Register Unit and							REC
nstallation Date:	Met	er installed by:	· ,				JUN 1
s This Meter (check one): [	 ☐ New ☐ Repaire	ed 🔲 Replacement					Di.
Important: By submitt	ing the above info For agricultura	rmation you are cer il wells, a list of app	tifying that th roved meters	is meter was is on the MI	s installed to DEQ websit	o manufac e.	BY: OL
HEREBY CERTIFY that the			***				
			est of my kno		Pa	0	

Form: OLWR-SWR-1B (4/13)

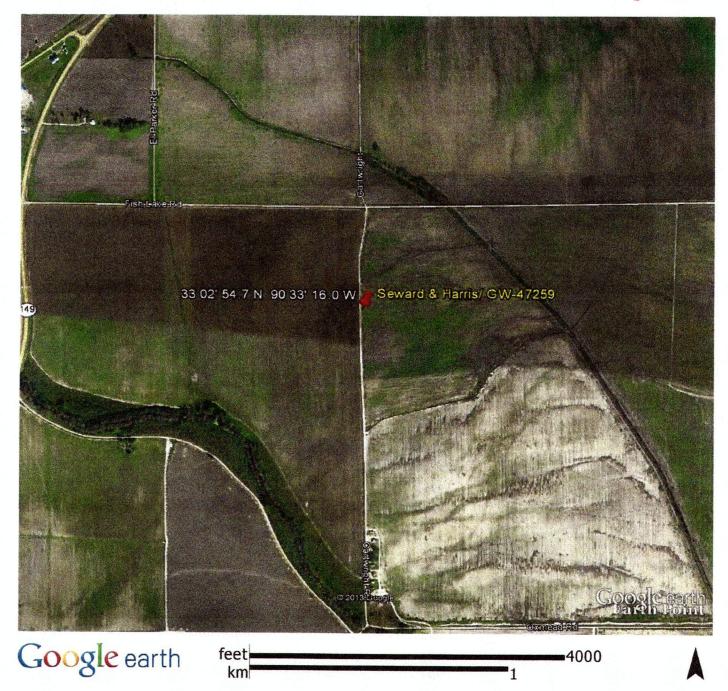

RECEIVED
BY: OLWA