
State W	ell Report				
ł // 1 1	Driller's Log For Office Use Only	' :			
	t of Environmental Quality Aquifer:				
Permit#: 113 (21/2 78/6) Office of I and	and Water Resources				
	1	<u>:</u>			
Jackson, N	IS 39289-0631 L. S. Elevation:				
(601)35 (601)	961-5210 4 6038 (for)				
(001)55	(601)354-6938 (fax) E-log #:				
State Law requires that this report be prepared by the lic Department at the above address within 30 days of comp	ense holder responsible for the work and filed with t Aletion of drilling of the well or horehole	he			
Information on Well Owner	Well or Borehole Location				
(Landowner if borehole is not for a water well)	1 1 2 2 2 4/ 15 mm x 90 a 20 as	-/ -/-			
Owner Name Perco Partyeiship	Latitude: 33 ° 4 255,34" Longitude: 90 ° 30 5	. 6.61"			
Mailing Address: P.O. Box 130	Method of Lat/Long (circle one): Conventional Survey,				
	USGS quad Hand-held GPS Survey-grade GPS	, ,			
Silve City MS 39166 City State Zip Code	SE 14 SW 14 Sec OH Twn 14N Rng 63				
•	Distance Direction Nearest Town 2 Miles SW of Silvy City, A	110			
Telephone No. (662) 247-5648					
Well / Bore	l hole Data				
Date drilling started: 5/6/15 Date drilling completed: 5/6/	K Holodovsky 115' Wale II . 77"				
Date of mining completed:	Hole depin: Hole diameter: 22	<u></u>			
Date drilling started: 5/6/15 Date drilling completed: 5/6/ Location of the source of any surface water used for drilling:	nile west of well site	_			
Logs run (circle all applicable): No log run Electric Gamma Ray Name of organization running log(s):	Density Sonic Neutron Other:	_			
Purpose of borehole (check one): Water Well X Geotechnical/Geole	ogical Investigation Ground Source Heat Pump	-			
	Seismic SurveyOther (describe)				
If drilling is not related to water well construction, skip the remainder of this block					
Purpose of Well (check one): HomeIndustrialPublic SupplyIrrigation X Fish CultureOther.					
If a flowing well, method of flow regulation: Valve Other (describe)					
Static Water Level:feet above or below (circle one) land surface Date measured:					
Method of Measurement (circle one) steel tape electric tape air line other:					
Well depth: 115 Well grouted to a depth of 10 feet Type of grout (circle one): Neat Cement Bentonite Mix					
Casing length: 75 feet Casing diameter: 16 inches Type of casing: PVC					
Screen length: 40 feet Screen diameter: 16 inches Type of screen: PVC					
Screen slot size: 1037 inches Setting depth: From 75 feet to 115 feet					
Type of completion (circle all applicable): Gravel packed Underreamed Telescoped Open hole Natural Development					
Other (describe):					
Top of lap pipe or reduction in casing: feet. If tel	escoped or more than one screen, describe on next page	1			

rm: OLVIRESWREIAW

<u>Description of formations encountered must be provided for all</u> wells and boreholes, unless specifically exempted by regulations

If well telescopes, show depths on sketch.			
Ground Level	Description of Formations Encountered	From (depth)	To (dept
	100 SOIL + CINV	Ground Level	15
ļ , , , , , , , , , , , , , , , , , , ,	Clay.	13	45
	Sold Clay mix	45	65
P Soil & clay 15	Control & grave	45	115
y	3		
21. 30'			ļ
Clay			
			<u> </u>
			<u> </u>
Sewel Jelay mix Zo'			
suri jeing in the			
			
parce of great 30			
		-	
If more than one screen, show location of each on ske	etch		
Shotoh the property levent and included fill in 194	111		
Sketch the property layout and include the following: 1) the	le well location; 2) any permanent structures on the lines, or other items that may aid in locating the pro-	property that may	1.
4) a north arrow.	mics, or other nems mat may are in rocating me pro	operty and the wei	1,
•	•		ļ
	•		
	·		
	Bread Breas		,
	A <i>a</i> a	Y 1 8 2015	
	. WIF	AI TO COID	
I d		OLWR	
Landowner Name:		a Basel VIII I	١ .
	Form	: OLWR-SWR-1/	A (04/08)
I certify that the well/borehole was drilled, constructed,	and completed in accordance with all applicable	requirements of	the
Mississippi Department of Environmental Quality and the			
laws.	<u> </u>		o L
Tommy Kacock Lict -3409	5/11/15 Town 1	feall	
Print Name of Responsible Licensee and License No.	Date Signature of Licens	see	
	5	•	

The sketch below only required for water wells

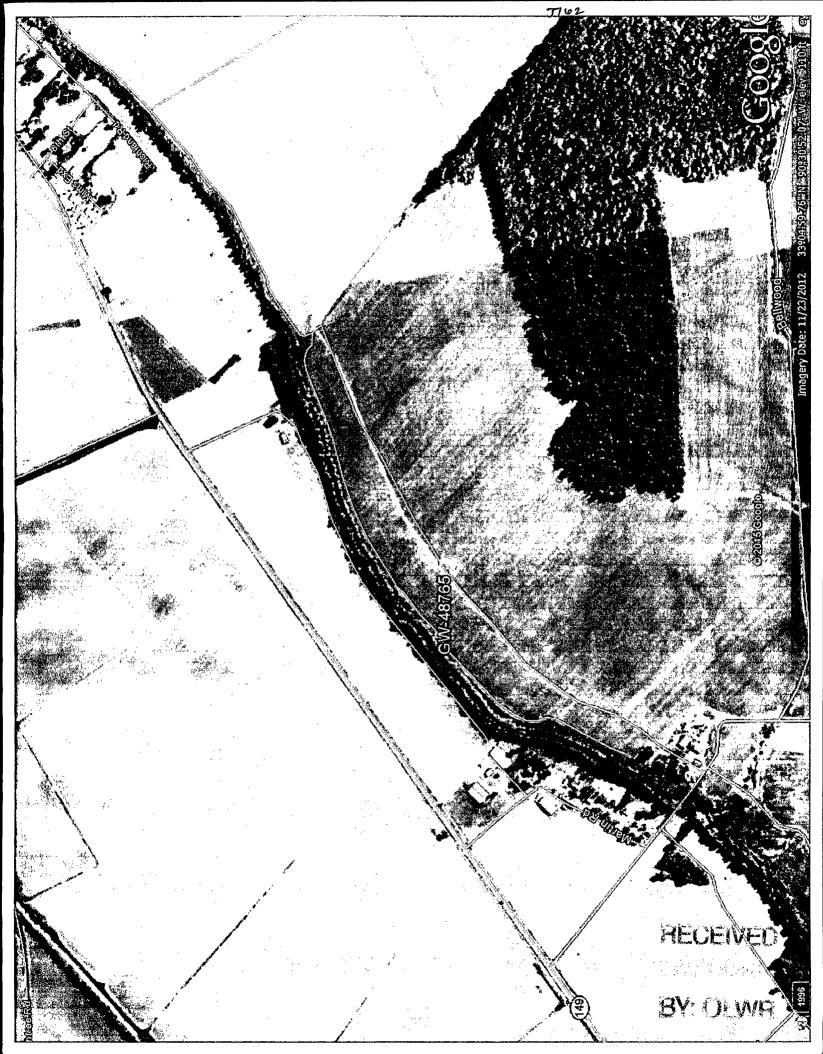

STATE OF MISSISSIPPI

Department of Environmental Quality Office of Land and Water Resources P. O. Box 2309 Jackson, Mississippi 39225

PERMIT

TO DIVERT OR WITHDRAW FOR BENEFICIAL USE THE PUBLIC WATERS

This permit is issued to the landowner named below in accordance with the provisions of the Mississippi Water Laws, Mississippi Code Sections 51-3–1, et seg.(1972, as amended), and the regulations and standards as promulgated thereunder. Whether or not specifically named in this permit or in the applications for this permit, anyone using water from the diversion/withdrawal point described below shall do so in compliance with the provisions of this permit. Neither this permit, nor any authority conferred hereby, may be sold, conveyed, encumbered, assigned, or otherwise aliened, for any period of time or under any conditions whatsoever. This permit may not be modified, transferred or revoked without prior action by the Permit . Board. Any attempts to modify, transfer or revoke this permit, or to take any other action on this permit, shall be invalid and unenforceable and may result in immediate revocation or suspension of this permit. The holder of this permit shall at all times be responsible for adherence to the terms and conditions of this permit. No agreement between the permit holder and any other party shall affect the obligations and liabilities of the permit holder. Water use under this permit is allowed only when the streamflow, lake level clovation, or static groundwater level (whichever, if any, is applicable) is above the established minimum, pursuant to Mississippi Code Section 51-3-7. Authorization is hereby granted to divert/withdraw water for the beneficial use designated herein, and for no other purpose, subject to the following terms, conditions, and limitations:

Permit Number: MS-GW-48765

Landowner Name: PEBCO PARTNERSHIP

Landowner Address: PO BOX 130

SILVER CITY

39166

Source Of Water: MISSISSIPPI RIVER VALLEY ALLUVIAL AQUIFER

Beneficial Use: IRRIGATION

Diversion/Withdrawal Location: SE 1/4 of the SW 1/4

Section: 04 Township:14M

County: HUMPHREYS

Maximum Volume: 329 Acre-Feet/Year

Quad: MIDNIGHT .equivalent to .2937 Million Gallons/Day

Maximum Rate: 2500 Gallons/Minute

Applicant Name: PEBCO PARTNERSHIP

Applicant Address: PO BOX 130

SILVER CITY

Date Permit issued: 03/18/2015 Date Permit Expires: 03/18/2020

Date Permit Modified: Date Permit Re-issued:

This permit shall be deemed null and void if construction has not begun within ond (1) year of permit

issue date

SPECIAL TERMS AND CONDITIONS:

SPECIAL TERMS AND CONDITIONS 2: SEE ATTACHMENT 1, WHICH IS HEREBY DECLARED TO BE PART OF THIS PERMIT.

MAY 18 2015

Kay Whittington Office Director

BY: OLWR

Control of the Contro and the second of the second Section 18

The state of the s

Commence of the second second

and the second of the second o

and a second a second and a second a second and a second

estato de la vivir de la companya d

₹