

HUMPHREYS MISSISSIPPI BOARD OF WATER COMMISSIONERS

K 14
5-62


WATER WELL DRILLERS LOG **CODED**

Date: MAY, 1962, Driller: DAVID BERRY County Humphreys
(Name)

		Description & Color of Materials Sand, Clay, Red Clay, Shell, etc.	Thick- ness Feet	Depth Feet
(1) Owner of Land:	<u>SEWARDSON</u> (Name)	<u>Surface</u>	20	
	<u>LOUISE, MISS</u> (Address)	<u>Clay</u>	20	40
(2) Location:	<u>1/4, 1/4, Sec. 32 T. 13 R. 4</u>	<u>11 ft. sand</u>	20	60
	<u>4 miles SW of LOUISE</u> (distance) (direction) (Nearest Town)	<u>sand</u>	20	80
(3) Topography:	<u>FLAT</u> (Hilly) (Flat) (Level)	<u>sand</u>	20	100
(4) Purpose of Well:	<u>DOMESTIC</u> (Domestic Irrigation Municipal, Industrial, Other)	<u>hard sub. of gravel</u>	20	120
		<u>sand & gravel</u>	20	140
		<u>(12" pipe at 146')</u>		
		<u>fine sand</u>	20	160
		<u>blue clay sub. of sand</u>	20	180
		<u>blue clay sandy shale</u>	20	200
		<u>sandy shale</u>	20	220
		<u>sandy shale</u>	20	240
		<u>sandy shale</u>	20	260
		<u>sandy shale</u>	20	280
		<u>sand</u>	20	300
		<u>sand</u>	20	320
		<u>sand</u>	20	340
		<u>sand</u>	20	360
		<u>sand sub. of shale</u>	20	380
		<u>shale 5' of sand</u>	20	400
		<u>sand sub. of shale</u>	20	420
		<u>shale</u>	20	440
		<u>shale sub. of sand</u>	20	460
		<u>" " " "</u>	20	480
		<u>brown shale</u>	20	500
		<u>shale sub. of sand</u>	20	520
		<u>" " " "</u>	20	540
		<u>sand sub. of shale</u>	20	560
		<u>" " " "</u>	20	580
		<u>" " " "</u>	20	600
		<u>" " " "</u>	20	620

Information upon completion of well:

- (1) Diameter 4 1/2 inches.
- (2) Total Depth 1300 feet.
- (3) Water Level 2' feet below top of ground.
- (4) Cased to 156', Size 4"
- (5) Screen: Size .008, Length 20
- (6) Were any formations sealed against pollution?
 yes,
 no

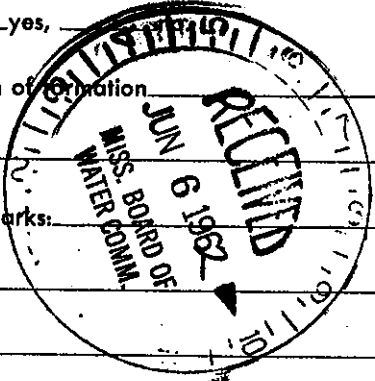

(Use Back Side)

Well No.

Mail this copy to Board of Water Commissioners 429 Miss. St. Jackson, M